CIVIL WORKS CITY OF WHITTLESEA 405 EPPING ROAD, WOLLERT VIC 3750 STAGE 2




GENERAL NOTES

- THESE DRAWINGS ARE TO BE READ IN CONJUNCTION WITH EDCM GUIDELINES. WHITTLESEA CITY COUNCIL SPECIFICATIONS AND STANDARD DRAWINGS. WORKS SHALL BE CARRIED OUT TO THE SATISFACTION OF THE SUPERINTENDENT OR HIS/HER REPRESENTATIVE.
- THE COUNCIL AND ALL SERVICE AUTHORITIES SHOULD BE NOTIFIED BY THE CONTRACTOR, IN WRITING, SEVEN DAYS PRIOR TO COMMENCEMENT OF THE WORKS, ALL EXISTING SERVICES IN THE VICINITY OF THE WORKS ARE TO BE LOCATED PRIOR TO COMMENCEMENT
- THE CONTRACTOR SHALL ENSURE THAT NO POLITITANT OR SEDIMENT LADEN RUNGER IS THE CONTRACTOR STALL ENDOZE THAT IN OFFICE TAND TO SEDIMENT LADER NONOFFIS DISCHARGED DIRECTLY OR INDIRECTLY INTO ANY DRAINS OR WATER COURSES AND THAT WORKS CONFORM TO THE ENVIRONMENTAL MANAGEMENT PLAN.
- RUNOFF FROM AREAS ON WHICH EARTHWORKS ARE CARRIED OUT MUST BE COLLECTED AND TREATED TO THE SATISFACTION OF THE RESPONSIBLE AUTHORITY BY THE USE OF OPEN DRAINS, FILTRATION TRAPS AND RETARDING BASINS IN THE PERIOD BETWEEN THE COMMENCEMENT OF CONSTRUCTION WORKS AND THE END OF THE MAINTENANCE PERIOD ACCORDANCE WITH THE ENVIRONMENT MANAGEMENT PLAN FOR THE SUBDIVISIONAL
- THE CONTRACTOR SHALL COMPLY WITH ALL OCCUPATIONAL HEALTH AND SAFETY PROCEDURES AND REQUIREMENTS.
- 6. AT LEAST 3 DAYS BEFORE COMMENCING EXCAVATION OF TRENCHES IN EXCESS OF 1.5m DEPTH, A COMPLETED 'NOTICE OF INTENTION TO COMMENCE TRENCHING OPERATIONS' FORM SHALL BE SENT TO WORKSAFE VICTORIA. THE NOMINATED SUPERVISOR SHALL BE SUITABLY QUALIFIED IN ACCORDANCE THE VICTORIAN OF ACT 2004 & WORK HEALTH & SAFETY (EXCAVATION WORK) CODE OF PRACTICE 2015 AND VICTORIAN COMPLIANCE CODE
- THE CONTRACTOR SHALL ERECT AND MAINTAIN ALL SHORING, PLANKING AND STRUTTING, DEWATERING DEVICES, BARRICADES, SIGNS, LIGHTS, ETC., NECESSARY TO KEEP WORKS IN A SAFE AND STABLE CONDITION AND FOR THE PROTECTION OF THE PUBLIC.
- ALL TREES AND SHRUBS ARE TO BE RETAINED UNLESS APPROVAL IS GIVEN BY COUNCIL'S ANDSCAPE OFFICER OR REMOVAL HAS BEEN GRANTED IN A PLANNING PERMIT.
- 9. DISPOSAL OF EXCESS SPOIL:- TRUCK ROUTE AND DISPOSAL LOCATION SHALL BE APPROVED BY THE SUPERINTENDENT
- 10 ALL AREAS SHOWN ON THE DRAWINGS TO BE CUT OR FILLED ARE TO BE STRIPPED OF ALL AREAS SHOWN ON THE DRAWINGS TO BE COT ON FILLED ARE TO BE STRIPPED OF TOPSOIL TO A DEPTH AS SPECIFIED IN GEOTECHNICAL REPORT PREPARED BY GEOTESTA GE655G-19. UPON COMPLETION OF THE BULK EARTHWORKS, THE TOPSOIL IS TO BE SPREAD TO A DEPTH OF 100mm OVER THE AREA AND GRADED TO FINISHED LEVELS SHOWN ON THE DRAWINGS AND TO THE SATISFACTION OF THE SUPERINTENDENT. ALL FILLING ON LOTS IN EXCESS OF 300mm IS TO BE CARRIED OUT IN ACCORDANCE WITH AS 3798 2007 APPENDIX B, SECTION BOX A TOPE 1 A TOWN LETON A THE CONTRACTOR SHALL DRESENT A SOU! SECTION B2(A) 'LEVEL 1'. AT COMPLETION, THE CONTRACTOR SHALL PRESENT A SOIL REPORT FROM A N.A.T.A TESTING AUTHORITY, NOMINATING THE EXTENT OF FILL AND IT'S CONFORMANCE WITH THE SPECIFICATION, FILLING TO BE CARRIED OUT USING APPROVED MATERIAL. TOPSOIL AND ALL VEGETABLE MATERIAL TO BE STRIPPED FROM FILL SITE PRIOR TO ANY PLACEMENT OF MATERIAL ALL FILLING IS TO BE COMPACTED IN 150mm. MAX. DEPTI LAYERS TO 95% OF AS1289.5.1.1 (STANDARD COMPACTION) 2003.
- 11. ALL STORMWATER DRAINS ARE TO BE CLASS '2' RC OR FRC PIPES UNLESS OTHERWISE SHOWN, ALL RC PIPES UP TO AND INCLUDING 750mm DIA, ARE TO BE RUBBER RING JOINTED, INTERLOCKING / FLUSH JOINTS WITH EXTERNAL BANDS MAY BE USED ON PIPES OVER 750mm DIA. WITH APPROVAL FROM WHITTLESEA CITY COUNCIL.
- 12 TELECOMM CONDUITS AND CABLE DUCTS WILL BE LAID IN TRENCHES EXCAVATED AND AUTHORITY AREA ENGINEER 7 DAYS NOTICE PRIOR TO COMMENCING WORK.
- 13. 100mm DIAMETER AGRICULTURAL DRAINS TO BE CONSTRUCTED BEHIND ALL KERB AND CHANNEL IN ACCORDANCE WITH EDCM FIGURE 202 AND LAID BELOW SUBBASE OF ROAD PAVEMENT WITH CLEARANCE TO ALL SERVICE CONDUITS.
- 14. WHERE DRAINAGE PIPES ARE LAID ON A CURVE THE BUILDING LINE IS TO BE PEGGED AT
- 15. THE REINSTATEMENT AND COMPACTION OF SERVICE AUTHORITY TRENCHES SHALL BE THE CONTRACTOR'S RESPONSIBILITY
- 16. ALL P.S.M.s SHALL BE HIGH STABILITY TYPE AND LEVELLED BY A LICENSED SURVEYOR AND THE P.S.M. DATA SHALL BE FORWARDED TO COUNCIL.
- 17. ALL CONDUIT ENDS SHALL BE PLUGGED WITH DRAW WIRE AS APPROPRIATE.
- ALL DRAINAGE TRENCHES WITHIN 5.0m OF ANY TREE TO BE RETAINED SHALL BE THRUST BORED OR HAND DUG.
- 19. FILL MATERIAL UNDER ROAD PAVEMENT SHALL BE APPROVED MATERIAL AND CONSTRUCTED IN LAYERS OF 150mm THICKNESS WITH COMPACTION ACHIEVING 98% (STANDARD COMPACTION) AT A MOISTURE RATIO OF 90% TO 110% OF AS1289.5.1.1 2003.
- 20. ALL LINEMARKING AND SIGNAGE SHALL BE IN ACCORDANCE WITH AS1742.1 2014 AND AS1742.2 2009. LONG LIFE PAINT SHALL BE USED FOR LINEMARKING.
- 21. ALL ELECTRICITY CONDUITS ARE TO BE A MINIMUM 63mm DIAMETER. ALL TELSTRA CONDUITS ARE TO BE A MINIMUM 100mm DIAMETER. REFER TO ELECTRICAL AND TELECOMMUNICATION PLANS FOR DETAILS.
- 22. THE CONTRACTOR SHALL NOTE THE EXISTENCE OF TELECOMMUNICATIONS. GAS POWER WATER AND ANY OTHER SERVICES IN THE AREA PRIOR TO TENDERING / CONSTRUCTION.
- ANY DISTURBANCE TO EXISTING INFRASTRUCTURE DUE TO CONSTRUCTION WORKS SHALL BE RECTIFIED AT THE CONTRACTOR'S EXPENSE.
- 24. ALL NATURE STRIPS AND BATTERS SHALL BE COVERED WITH 100mm MIN. DEPTH TOPSOIL AND SEEDED WITH AN APPROVED SEED AND FERTILIZER MIXTURE AS PER EDCM
- a. CONDUITS UNDER FOOTPATHS TO BE 450mm DEEP EXTENDING 250mm EITHER SIDE OF THE PATH THE FOOTPATH ABOVE THE CONDUITS SHALL BE MARKED WITH TWO CONTRACTION JOINTS OVER THE CONDUITS 400mm APART.
 - CONDUITS SHALL BE REFERENCED ON BOTH FOOTPATH AND KERB & CHANNEL. CONDUITS INSTALLED UNDER ROAD PAVEMENTS SHALL EXTEND 1 METRE INSIDE THE ALLOTMENTS WHERE FOOTPATH IS PROPOSED
- ALLO IMENTS WHERE POUTFAIN IS PROPOSED.

 G SAT O BE 50mm DIA. CLASS 12 PVC & WATER CONDUIT TO BE DN100 SINGLE CONDUIT CONTAINING BOTH DW & NDW SERVICES LAID IN ACCORDANCE WITH WSA 03-2011-3.1 AND DRAWING MRWA-W-202 & MRWA-W-110.
- 27. UPON COMPLETION OF THE WORKS THE WHOLE SITE SHALL BE CLEANED AND ALL RUBBISH REMOVED, LOTS ARE TO BE GRADED EVENLY AND THE SITE LEFT IN A CLEAN AND TIDY CONDITION TO THE SATISFACTION OF THE SUPERINTENDENT

- J. G. GOIL SHALL BE REMOVED FROM THE SITE.
 INSPECTIONS SHALL BE ARRANGED A MINIMUM OF 24 HOURS BEFORE WITH COUNCILS ASSETS ENGINEER. 28 NO TOPSOIL SHALL BE REMOVED FROM THE SITE
- 30. STREET SIGNS SHALL BE MANUFACTURED IN ACCORDANCE WITH WHITTLESEA CITY COUNCIL STANDARDS INCLUDING LOGO AND TO COMPRISE TWO FINGER BOARDS
- 31. 24 HOURS NOTICE IS REQUIRED FOR INSPECTION AT THE FOIL OWING HOLD POINTS:
 - PRIOR TO COMMENCEMENT OF THE WORKS.
- INSPECTION OF THE SUBGRADE.
 INSPECTION DURING DRAINAGE WORKS
- INSPECTION PRIOR TO POURING OF PITS.
- INSPECTION OF SUB SOIL DRAINAGE.
- INSPECTION OF KERB AND CHANNEL BEDDING.
- INSPECTION OF KERB AND CHANNEL BEDDING.
 INSPECTION PRIOR TO ANY CONCRETE WORKS.
 INSPECTION PRIOR TO ANY CONCRETE WORKS.
 INSPECTION AND TESTING OF EACH PAVEMENT LAYER (BY DEVELOPER OR CONTRACTOR) PRIOR TO PLACING ANY SUBSEQUENT PAVEMENT LAYER. COMPACTION TEST RESULTS SHALL BE ISSUED TO COUNCIL.
 INSPECTION PRIOR TO SEALING AND ASPHALT WORKS.
- 32. COUNCIL WILL NOT ACCEPT ANY RESPONSIBILITY FOR WORKS WHERE AN INSPECTION IS NOT UNDERTAKEN WITH A COUNCIL APPOINTED REPRESENTATIVE
- 33. ALL DIMENSIONS ARE IN METRES AND RADII TO LIP OF KERB UNLESS OTHERWISE SHOWN.
- 34. LEVELS ARE TO A.H.D. AND TAKEN FROM LEVEL PLANS BY TAYLORS DEVELOPMENT STRATEGISTS. SETOUT CO-ORDINATES ARE BASED ON MGA ZONE 55.
- 35. PITS SHALL BE LOCATED USING OFFSETS AND CO-ORDINATES SHOWN ON DRAWINGS.
- 36. ALL DRAINS BENEATH ROAD PAVEMENT, PATHS, DRIVEWAYS AND PARALLEL TO KERB SHALL AEL OVANINS BENEATH YOUTH PAYOMENT, PATHS, DANCHARDS AND PARAULEL TO TARES SHALL BE BACKFILLED WITH 20mm CLASS 2 F.C.R. ALL BACKFILLING TO BE COMPACTED TO 98% OF AS1289.5.1.1 2003 (STANDARD COMPACTION). DRAINS BEHIND THE BACK OF KERB SHALL BE BACKFILLED USING SELECT FILL COMPACTION OF THE DRAINAGE LINE SHALL BE 56% STANDARD COMPACTION TO AS1289.5.1.1 2003 AND ALL TEST RESULTS SHALL BE
- 37. HOUSE DRAINS SHALL GENERALLY BE PLACED 5.5m FROM THE LOW CORNER OF THE LOT. AS PER STD DWG EDCM 701 AND PROPERTY INLETS 1 0m FROM AND 0 6m RELOW THE LOW CORNER OF THE LOT, UNLESS OTHERWISE SHOWN.
- 38. HOUSE NUMBERS TO BE STENCILED ON THE FACE OF KERB IN 100mm HIGH LETTERS
- 39. EXISTING OPEN CHANNELS TO BE EXCAVATED TO A FIRM BASE AND BACKFILLED IN ACCORDANCE WITH NOTE 10. CONSULTING ENGINEER TO BE NOTIFIED WHEN THE OPEN CHANNELS HAVE BEEN EXCAVATED TO A FIRM BASE. NO FILLING IS TO BE PLACED PRIOR TO BASE BEING INSPECTED AND LEVELS TAKEN. BACKFILLING IS TO BE CARRIED OUT TO THE SATISFACTION OF THE SUPERINTENDENT.
- 40. ALL PAVEMENT MATERIALS ARE TO BE APPROVED BY WHITTLESEA CITY COUNCIL
- 41. ALL PAVEMENTS ARE TO BE TESTED FOR ADEQUATE COMPACTION AND APPROVED PRIOR TO CONTINUING WORKS.
- 42. PRIOR TO THE ISSUE OF A STATEMENT OF COMPLIANCE, ALL NEWLY CONSTRUCTED ROADS. FOOTPATHS AND DRAINAGE ASSETS ARE TO BE RECORDED LINDER THE "D-SPEC" & "R-SPEC" SYSTEM AS SETOUT IN THE EDCM GUIDELINES AND THE RESULTS PROVIDED TO
- 43. NO FILL OR EXCAVATED MATERIAL FOR OR FROM THIS DEVELOPMENT IS TO BE CARTED/HAULED INTO OR FROM THE SITE, WITHOUT FIRST OBTAINING THE FURTHER WRITTEN CONSENT FROM COUNCIL'S ENGINEERING DEPARTMENT AT LEAST SEVEN (7) DAYS PRIOR TO THE CARTAGE/HAULAGE WORKS COMMENCING. TO THE SATISFACTION OF THE RESPONSIBLE AUTHORITY
- 44 ALL EARTHWORKS MUST BE LINDERTAKEN IN A MANNER THAT MINIMISES SOIL EROSION AND ANY EXPOSED AREAS OF SOIL MUST BE STABILISED TO PREVENT SOIL EROSION TO THE SATISFACTION OF THE RESPONSIBLE AUTHORITY.
- 45. EROSION MUST BE CONTROLLED DURING CONSTRUCTION IN ACCORDANCE WITH THE ENVIRONMENT PROTECTION AUTHORITY GUIDELINE TG208/90. CONTRACTOR TO PROVIDE SITE EMP.
- 46. ALL VEGETATION THAT IS REMOVED AND DISPOSED OF MUST:
- NOT CAUSE DAMAGE TO VEGETATION STANDS TO BE RETAINED.
 HAVE REGARD TO THE LOCAL LAW WHEN BURNING VEGETATION.
- 47. NATIVE VEGETATION REMOVAL TO BE LIMITED TO THE SPECIFIC PLANTS IDENTIFIED AS PART OF THE PLANNING PERMIT, NO ADDITIONAL NATIVE PLANTS, OUTSIDE OF THOSE SPECIFIED IN THE PLANNING PERMIT, ARE TO BE REMOVED
- 48. NO POLLUTED AND/OR SEDIMENT LADEN RUNOFF IS TO BE DISCHARGED, DIRECTLY OR
- 49. BEFORE THE VEGETATION REMOVAL STARTS, THE BOUNDARIES OF ALL VEGETATION TO BE REMOVED AND RETAINED MUST BE CLEARLY MARKED WITH TEMPORARY FENCING, TO THE SATISFACTION OF THE RESPONSIBLE AUTHORITY. THE REMOVAL MUST BE IN ACCORDANCE WITH THE ENDORSED PLAN
- 50 PRIOR TO FELLING TREES IDENTIFIED FOR REMOVAL MUST BE EXAMINED FOR THE PRIOR TO FELLING, IREES IDENTIFIED FOR REMOVAL MUST BE EXAMINED FOR THE PRESENCE OF FAUNA, INCLUDING THOSE USING EXTERNAL HESTS (e.g. COMMON RINGTAIL POSSUMS, BIRDS NESTS) AND TREE HOLLOWS. IF NATIVE FAUNA SPECIES ARE LOCATED, THEY ARE TO BE SALVAGED AND RELOCATED IN ACCORDANCE WITH ALL RELATIVE LEGISLATION AND APPROVALS, FURTHER TO CONSULTATION WITH THE DEPARTMENT OF SUSTAINABILITY AND ENVIRONMENT
- 51. ALL VEHICLES, EARTHMOVING EQUIPMENT AND OTHER MACHINERY MUST BE CLEARED OF ACL VEHICLES, ART HIMOVING EQUIPMENT AND OTHER MACHINERY MOST BE CLEARED SOIL AND PLANT MATERIAL BEFORE ENTERING AND LEAVING THE SITE, TO PREVENT THI SPREAD OF WEEDS AND PATHOGENS
- 52. DRIVEWAYS TO BE EXCAVATED INTO ALLOTMENTS AT A MAXIMUM GRADE OF 1 IN 5 WHERE
- 53. DRIVEWAY LAYBACK AND WINGS ARE TO BE CONSTRUCTED AS A SINGLE SEGMENT OF
- 54. ALL NBN PITS ARE TO BE CLEAR OF PATHS AND DRIVEWAYS.
- 55. CONTRACTOR TO PROVIDE CCTV TESTING ON ALL CONSTRUCTED DRAINAGE LINES AND TO BE APPROVED BY COUNCIL PRIOR TO THE ISSUE OF STATEMENT OF COMPLIANCE.
- 56. ALL RESIDENTIAL AND HEAVY DUTY DRIVEWAYS TO BE CONSTRUCTION ACCORDING TO MPA

DRAWING No.	DESCRIPTION	SHEET No.
21408-02-E-000	COVER SHEET	0
21408-02-E-100	GENERAL NOTES, LOCALITY PLAN, DRAWING INDEX & SERVICE OFFSET TABLE	1
21408-02-E-101	EXISTING FEATURES PLAN	2
21408-02-E-102	TYPICAL CROSS SECTIONS	3
21408-02-E-103	TYPICAL DETAILS	4
21408-02-E-104	OVERALL STAGING PLAN	5
21408-02-E-105	ROAD CENTRELINE SETOUT PLAN	6
21408-02-E-106	PLAN OF SUBDIVISION	7
21408-02-E-107	DETAIL LAYOUT PLAN	8
21408-02-E-108	ROAD LONGITUDINAL SECTIONS	9
21408-02-E-109	ROAD CROSS SECTIONS SHEET 1 OF 3	10
21408-02-E-110	ROAD CROSS SECTIONS SHEET 2 OF 3	11
21408-02-E-111	ROAD CROSS SECTIONS SHEET 3 OF 3	12
21408-02-E-112	INTERSECTION DETAILS AND KERB LIP PROFILES SHEET 1 OF 4	13
21408-02-E-113	INTERSECTION DETAILS AND KERB LIP PROFILES SHEET 2 OF 4	14
21408-02-E-114	INTERSECTION DETAILS AND KERB LIP PROFILES SHEET 3 OF 4	15
21408-02-E-115	INTERSECTION DETAILS AND KERB LIP PROFILES SHEET 4 OF 4	16
21408-02-E-116	SIGNS AND LINEMARKING PLAN	17
21408-02-E-117	DRAINAGE LONGITUDINAL SECTIONS SHEET 1 OF 2	18
21408-02-E-118	DRAINAGE LONGITUDINAL SECTIONS SHEET 2 OF 2	19
21408-02-E-119	DRAINAGE PIT SCHEDULE	20
21408-02-E-800	Q5 CATCHMENT PLAN	21

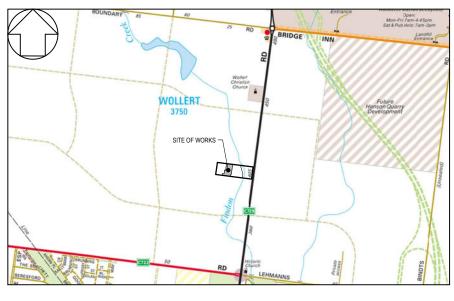

LOCALITY PLAN SCALE N.T.S. MELWAYS REF MAP 389 C10

SERVICE OFFSET TABLE												
STREET	GAS		RECYCLED WATER (NDW)		POTABLE WATER (DW)		TELECOMS		ELECTRICAL CABLES		SEWER	
	SIDE	OFFSET	SIDE	OFFSET	SIDE	OFFSET	SIDE	OFFSET	SIDE	OFFSET	SIDE	OFFSET
COTTONWOOD DRIVE	SOUTH	2.10m	SOUTH	2.50m	SOUTH	3.00m	NORTH	0.35m	NORTH	1.10m	SOUTH	Ex. 1.00m
BUTTERNUT STREET	SOUTH	2.10m	SOUTH	2.50m	SOUTH	3.00m	NORTH	1.85m	NORTH	2.60m	NORTH SOUTH	Ex. 1.00m Ex. 1.00m
BUNYA STREET	WEST	2.10m	WEST	2.50m	WEST	3.00m	EAST	1.85m	EAST	2.60m	EAST	1.00m
ILLAWARRA WAY	WEST	2.10m	WEST	2.50m	WEST	3.00m	EAST	1.85m	EAST	2.60m	-	-



WARNING

BEWARE OF UNDERGROUND SERVICES

THE LOCATIONS OF UNDERGROUND SERVICES ARE APPROXIMATE ONLY AND THEIR EXACT POSITION SHOULD BE PROVED ON SITE NO GUARANTEE IS GIVEN THAT ALL EXISTING SERVICES ARE SHOWN A MOCS ENOURRY ON 1100 MUST BE MADE BY THE CONTRACTOR PRIOR TO COMMENCEMENT OF WORKS.

WARNING

CONTRACTOR


SERVICE OFFSET TABLE


IT IS THE RESPONSIBILITY OF THE CONTRACTOR TO VERIFY THE SETOUT INFORMATION PROVIDED ON THIS PLAN WITH THE DESIGN INTENT WHICH INCLUDES BUT IS NOT LIMITED TO ITEMS. SUCH AS LENGTHS CO-ORDINATES SETOUT DIMENSIONS AND PEGGED TITLES BY THE PRINCIPAL'S LICENSED SURVEYOR.

> CONSTRUCTION ISSUED FOR CONSTRUCTION

									TWI	TVIAE	TIVLABE	TWI ABC	
													14) LUIK3
											Urban Development Infrastructure		
	1/12/2021	1 DRAWING INDEX UPDATED	WJB					8	8 / 270 Ferntree Gully Ro Tel: 61 3 9501 2800	8 / 270 Ferntree Gully Road, Notting Hill, Victo Te l: 61 3 9501 2800 Web : taylorsds.co.	8 / 270 Ferntree Gully Road, Notting Hill, Victoria, 3168 Tel: 61 3 9501 2800 Web: taylorsds.com.au	8 / 270 Ferntree Gully Road, Notting Hill, Victoria, 3168 Tel: 61 3 9501 2800 Web: taylorsds.com.au	8 / 270 Ferntree Gully Road, Notting Hill, Victoria, 3168 Tel: 61 3 9501 2800 Web: taylorsds.com.au
I	12/01/2021	ISSUED FOR CONSTRUCTION	MIO				DESIGNED:	DESIGNED: ALP	DESIGNED: ALP AUTHORISED:	DESIGNED: ALP AUTHORISED: JOY	DESIGNED: ALP AUTHORISED: JOY DRAFTED:	DESIGNED: ALP AUTHORISED: JOY DRAFTED: WGO	DESIGNED: ALP AUTHORISED: JOY DRAFTED: WGO
ĺ	DATE	REVISION	APPD.	Coords: MGA	Levels: AHD	•	CHECKED:	CHECKED: MIO	CHECKED: MIO AUTH. DATE:	CHECKED: MIO AUTH. DATE: 18/05/2020	CHECKED: MIO AUTH. DATE: 18/05/2020 CAD REF:	CHECKED: MIO AUTH. DATE: 18/05/2020 CAD REF: 21408-02-E-100	CHECKED: MIO AUTH. DATE: 18/05/2020 CAD REF: 21408-02-E-100

CITY OF WHITTLESEA	SCALE		AS SHOWN	
405 EPPING ROAD, WOLLERT VIC 3750	VERSION		1	
STAGE 2	SHEET	1	OF	21
STAGE 2	DRAWING	No.		
GENERAL NOTES, LOCALITY PLAN, DRAWING INDEX &	2140	Q_(∩2_E	100
SERVICE OFFSET TABLE		י־ט	UZ-L-	. 100

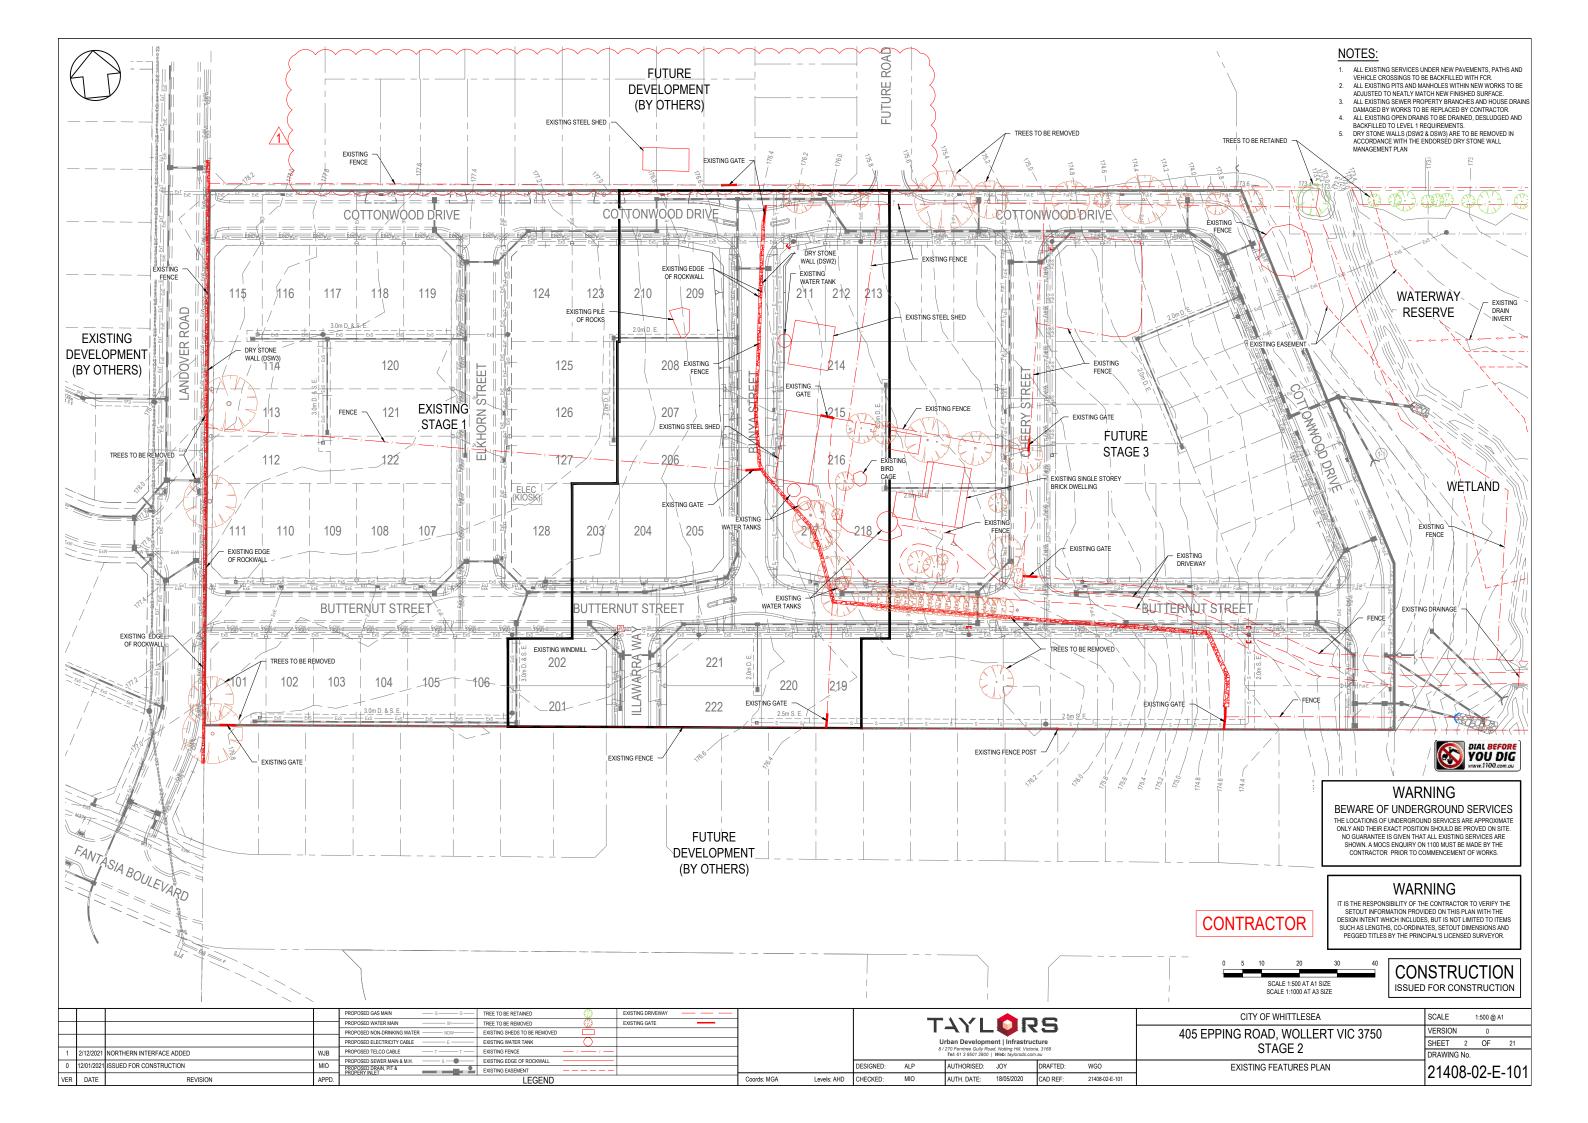

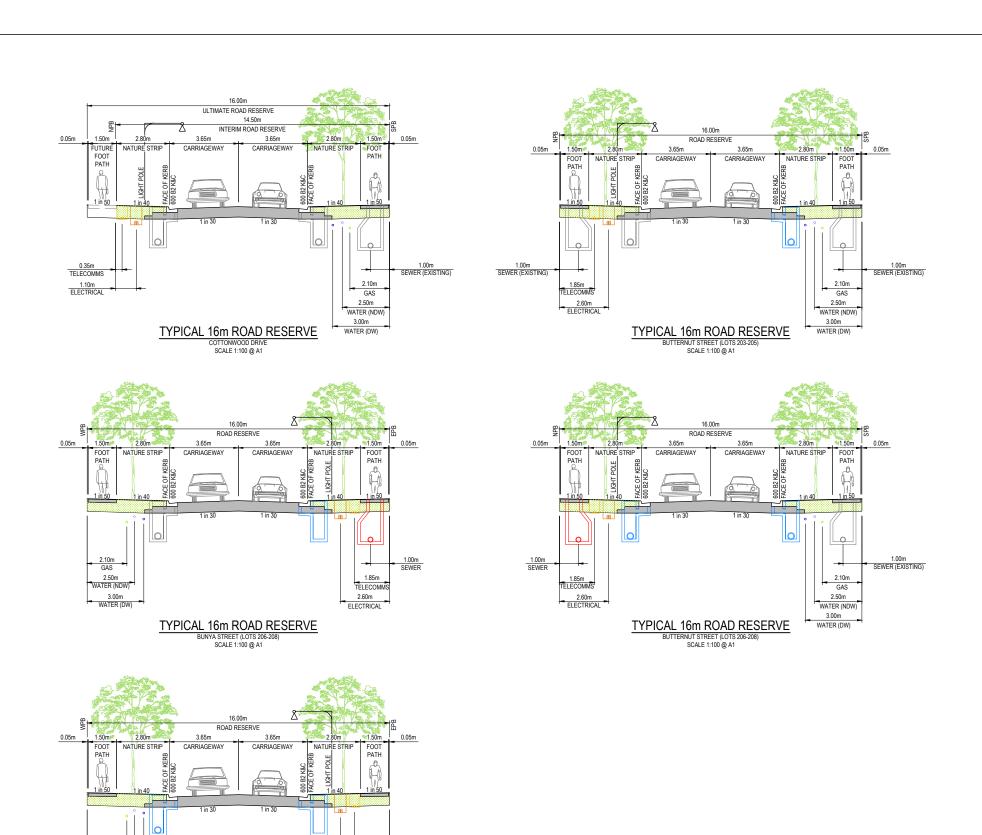

TELECOMMS



WARNING

BEWARE OF UNDERGROUND SERVICES

THE LOCATIONS OF UNDERGROUND SERVICES ARE APPROXIMATE ONLY AND THEIR EXACT POSITION SHOULD BE PROVED ON SITE. NO GUARANTEE IS GIVEN THAT ALL EXISTING SERVICES ARE SHOWN. A MOCS ENQUIRY ON 1100 MUST BE MADE BY THE CONTRACTOR PRIOR TO COMMENCEMENT OF WORKS.

CONTRACTOR

IT IS THE RESPONSIBILITY OF THE CONTRACTOR TO VERIFY THE SETOUT INFORMATION PROVIDED ON THIS PLAN WITH THE DESIGN INTENT WHICH INCLUDES, BUT IS NOT LIMITED TO ITEMS SUCH AS LEWGTHS, CC-ORDINATES, SETOUT DIMENSIONS AND PEGGED TITLES BY THE PRINCIPAL'S LICENSED SURVEYOR.

WARNING



CONSTRUCTION ISSUED FOR CONSTRUCTION

				1
0	12/01/2021	ISSUED FOR CONSTRUCTION	MIO	
VER	DATE	REVISION	APPD.	

TYPICAL 16m ROAD RESERVE ILLAWARRA WAY SCALE 1:100 @ A1


				U	rban Developm 270 Ferritree Gully Ro Tel: 61 3 9501 2800	ent Infrastru	cture	
		DESIGNED:	ALP		AUTHORISED:	JOY	DRAFTED:	WGO
Coords: MGA	Levels: AHD	CHECKED:	MIO		AUTH. DATE:	18/05/2020	CAD REF:	21408-02-E-102


CITY OF WHITTLESEA 405 EPPING ROAD, WOLLERT VIC 3750 STAGE 2

SCALE AS SHOWN VERSION SHEET 3 OF 21

TYPICAL CROSS SECTIONS

DRAWING No. 21408-02-E-102

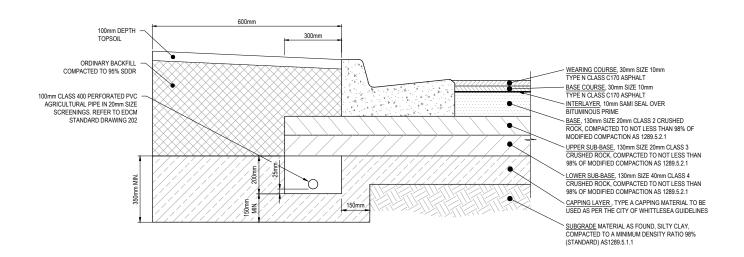

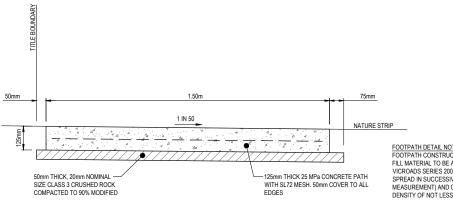


FOOTPATH DETAIL NOTE:
FOOTPATH CONSTRUCTED IN FILL SHALL BE USING STRUCTURAL
FILL MATERIAL TO BE APPROVED TYPE 'A' MATERIAL AS PER
VICROADS SERIES 200 DOCUMENT TABLE 204.04.
SPREAD IN SUCCESSIVE LAYERS NOT EXCEEDING 150mm (LOOSE
MEASUREMENT) AND COMPACTED THROUGHOUT TO A DRY
DENSITY OF NOT LESS THAN 98% STANDARD COMPACTION


TYPICAL RESIDENTIAL FOOTPATH DETAIL


SCALE 1:10 @ A1 (REFER TO EDCM STANDARD DWG 401)

COTTONWOOD DRIVE, BUNYA STREET, BUTTERNUT STREET & ILLAWARRA WAY 600mm PAVEMENT COMPOSITION DETAIL

NOTE: REFER TO GEOTECHNICAL REPORT GE6550-19 PREPARED BY GEOTESTA AND EDCM STANDARD DRAWING 202 FOR SUBSURFACE DRAIN DETAILS.

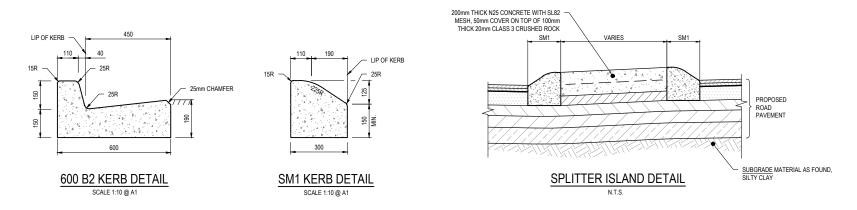

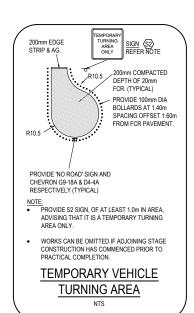

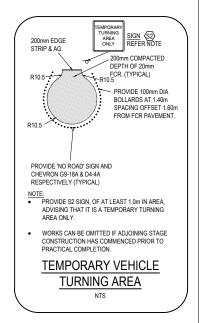



WARNING

BEWARE OF UNDERGROUND SERVICES

THE LOCATIONS OF UNDERGROUND SERVICES ARE APPROXIMATE ONLY AND THEIR EXACT POSITION SHOULD BE PROVED ON SITE. NO GUARANTEE IS GIVEN THAT ALL EXISTING SERVICES ARE SHOWN, A MOCS ENQUIRY ON 1100 MUST BE MADE BY THE CONTRACTOR PRIOR TO COMMENCEMENT OF WORKS.


CONTRACTOR


IT IS THE RESPONSIBILITY OF THE CONTRACTOR TO VERIFY THE SETOUT INFORMATION PROVIDED ON THIS PLAN WITH THE DESIGN INTENT WHICH INCLUDES, BUT IS NOT LIMITED TO ITEMS SUCH AS LENGTHS, CO-ORDINATES, SETOUT DIMENSIONS AND PEGGED TITLES BY THE PRINCIPAL'S LICENSED SURVEYOR.


WARNING





				TAVI OBS					CITY OF WHITTLESEA	SCALE AS SHOWN			
						Urban Development Infrastructure 8 / 270 Ferritee Guly Road, Noting Hil. Victoria, 3168 Tel: 61 3 907 280 Web: Telyondas.com.au			ucture		405 EPPING ROAD, WOLLERT VIC 3750 STAGE 2	VERSION 0 SHEET 4 OF 21 DRAWING No.	
0 12/01	/2021 ISSUED F	FOR CONSTRUCTION	MIO			DESIGNED:	ALP	AUTHORISED:	JOY	DRAFTED:	WGO	TYPICAL DETAILS	21408-02-E-103
VER DA	TE	REVISION	APPD.	Coords: MGA	Levels: AHD	CHECKED:	MIO	AUTH. DATE:	18/05/2020	CAD REF:	21408-02-E-103		Z 1400-02-E-103

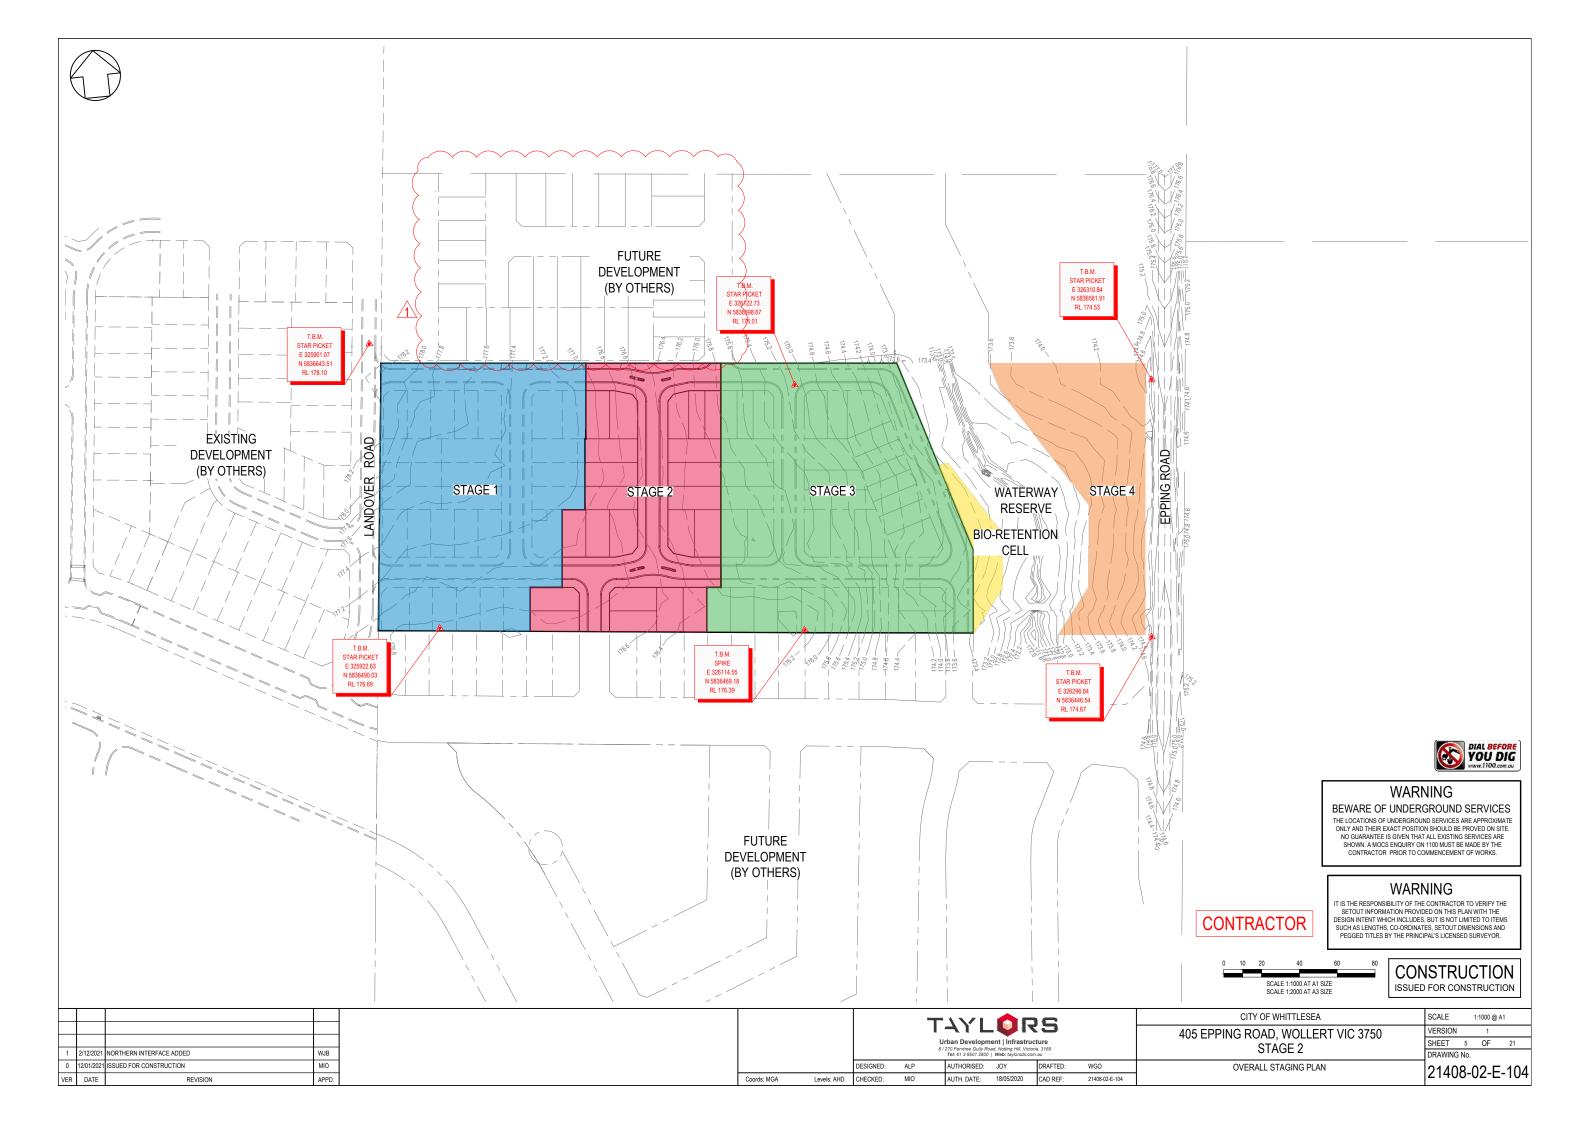


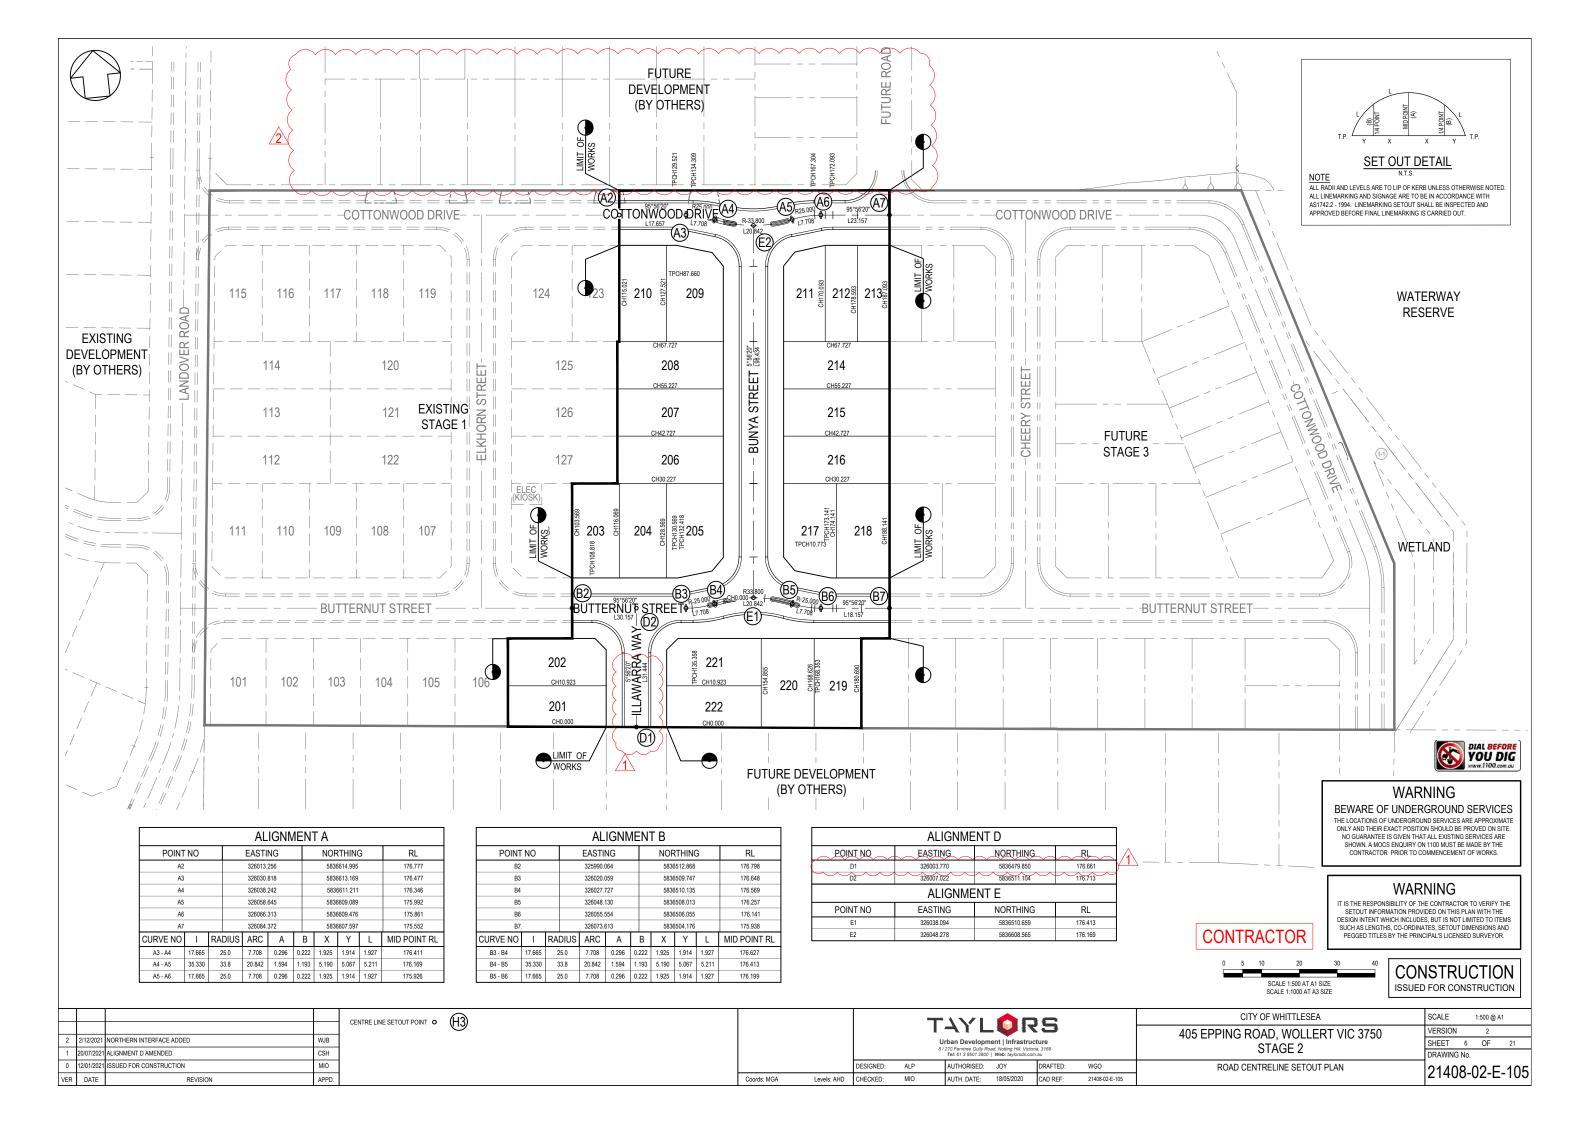


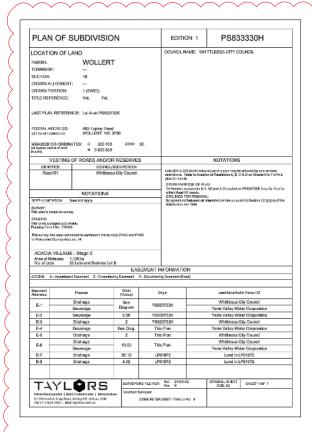


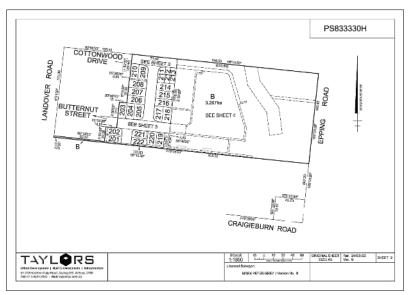


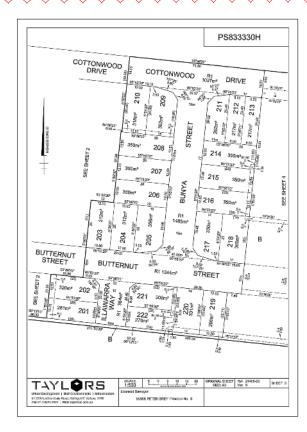

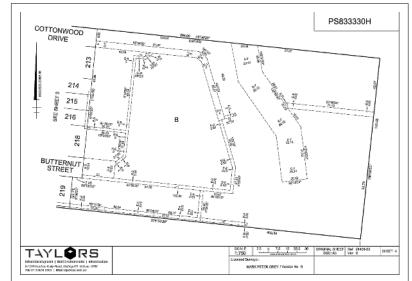

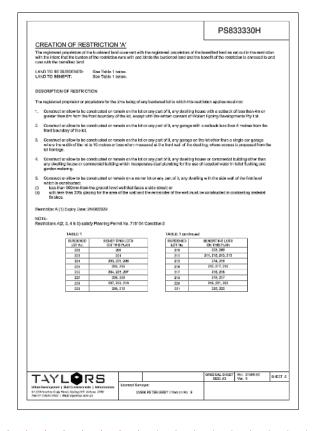

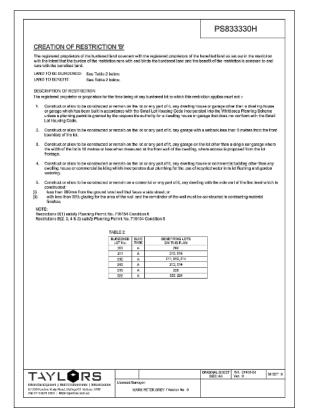

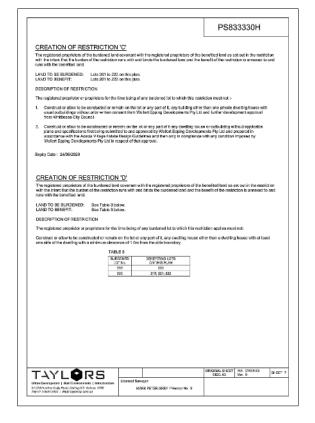



WARNING

BEWARE OF UNDERGROUND SERVICES

THE LOCATIONS OF UNDERGROUND SERVICES ARE APPROXIMATE ONLY AND THEIR EXACT POSITION SHOULD BE PROVED ON SITE. NO GUARANTEE IS GIVEN THAT ALL EXISTING SERVICES ARE SHOWN. A MOCS ENQUIRY ON 1100 MUST BE MADE BY THE CONTRACTOR PRIOR TO COMMENCEMENT OF WORKS.

CONTRACTOR

2

WARNING

IT IS THE RESPONSIBILITY OF THE CONTRACTOR TO VERIFY THE SETOUT INFORMATION PROVIDED ON THIS PLAN WITH THE DESIGN INTENT WHICH INCLUDES, BUT IS NOT LIMITED TO ITEMS SUCH AS LENGTHS, CO-ORDINATES, SETOUT DIMENSIONS AND PEGGED TITLES BY THE PRINCIPAL'S LICENSED SURVEYOR.

CONSTRUCTION ISSUED FOR CONSTRUCTION

2	26/08/2021	POS UPDATED TO V9	WJB
1	20/07/2021	POS UPDATED TO V8	CSH
0	12/01/2021	ISSUED FOR CONSTRUCTION	MIO
VER	DATE	REVISION	APPD.


					U	rban Developm	TAYLORS Urban Development Infrastructure 8/270 Ferntee Guly Mean Hollands com au Tele 67 3 3607 12600 Webt Hollands com au								
l			DESIGNED:	ALP		AUTHORISED:	JOY	DRAFTED:	WGO						
	Coords: MGA	Levels: AHD	CHECKED:	MIO		AUTH. DATE:	18/05/2020	CAD REF:	21408-02-E-106						


CITY OF WHITTLESEA
405 EPPING ROAD, WOLLERT VIC 375 STAGE 2


SCALE		N.T.S.		
VERSION		2		
SHEET	7	OF	21	
DRAWING	Nο			


PLAN OF SUBDIVISION


21408-02-E-106

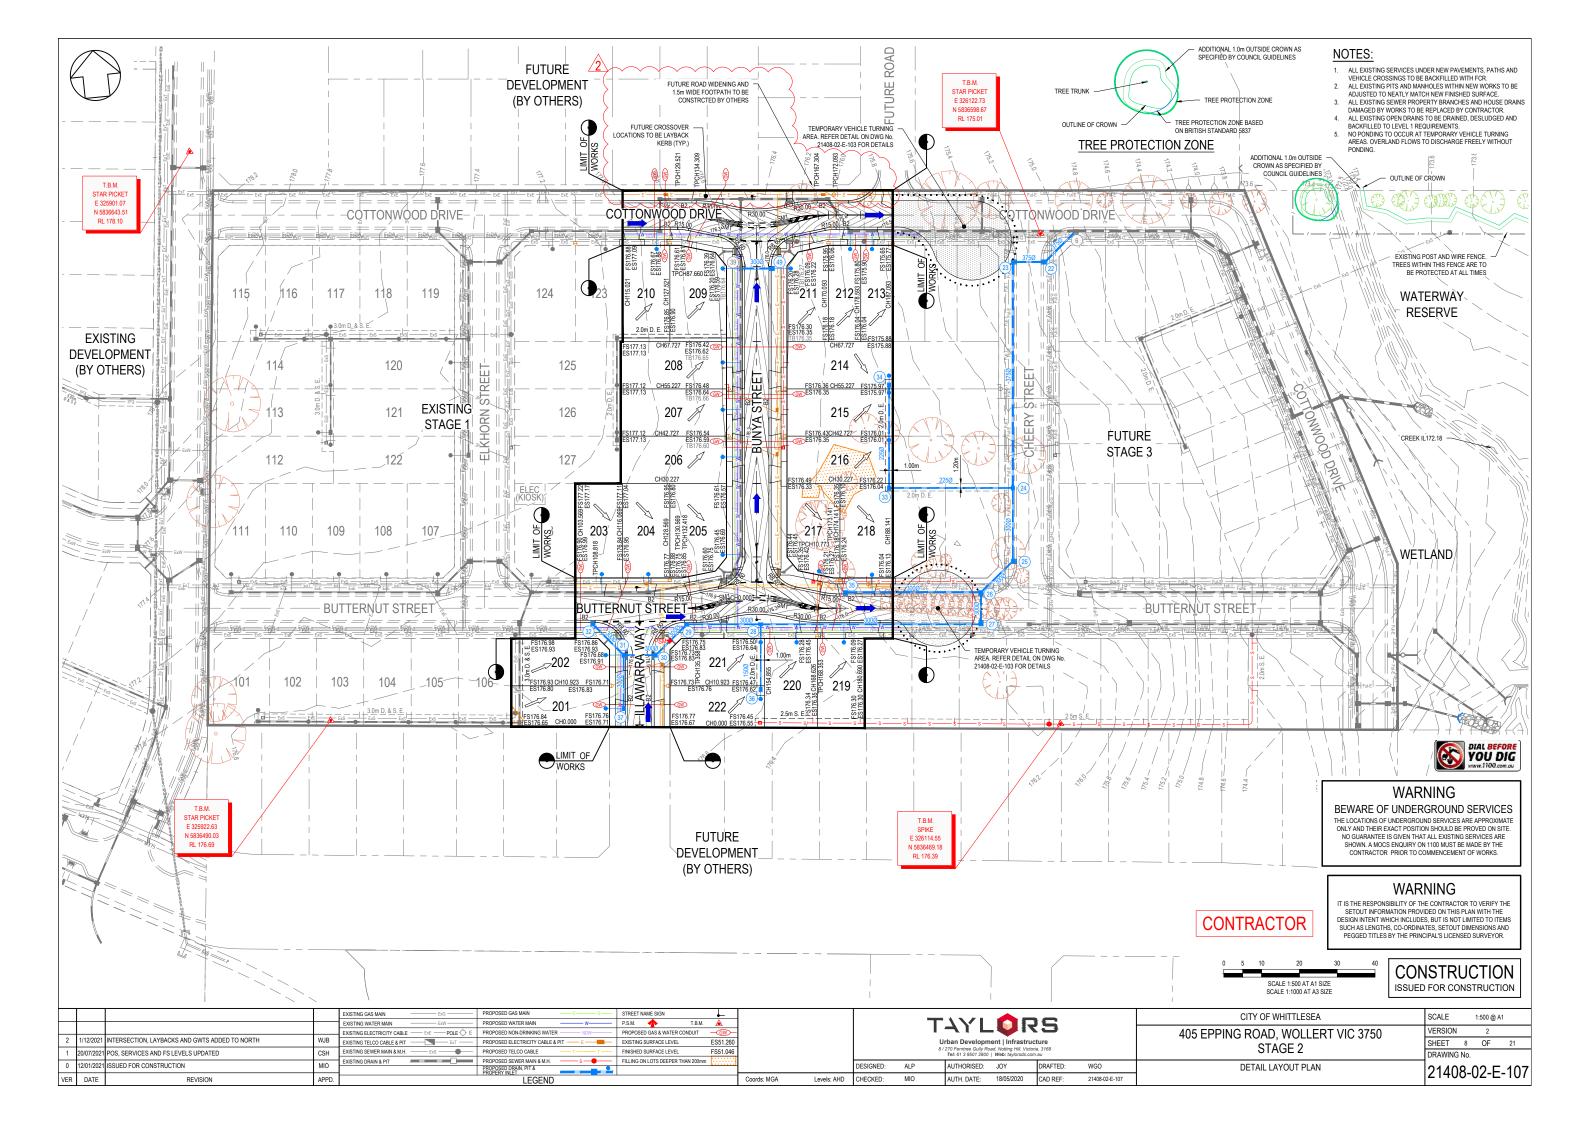


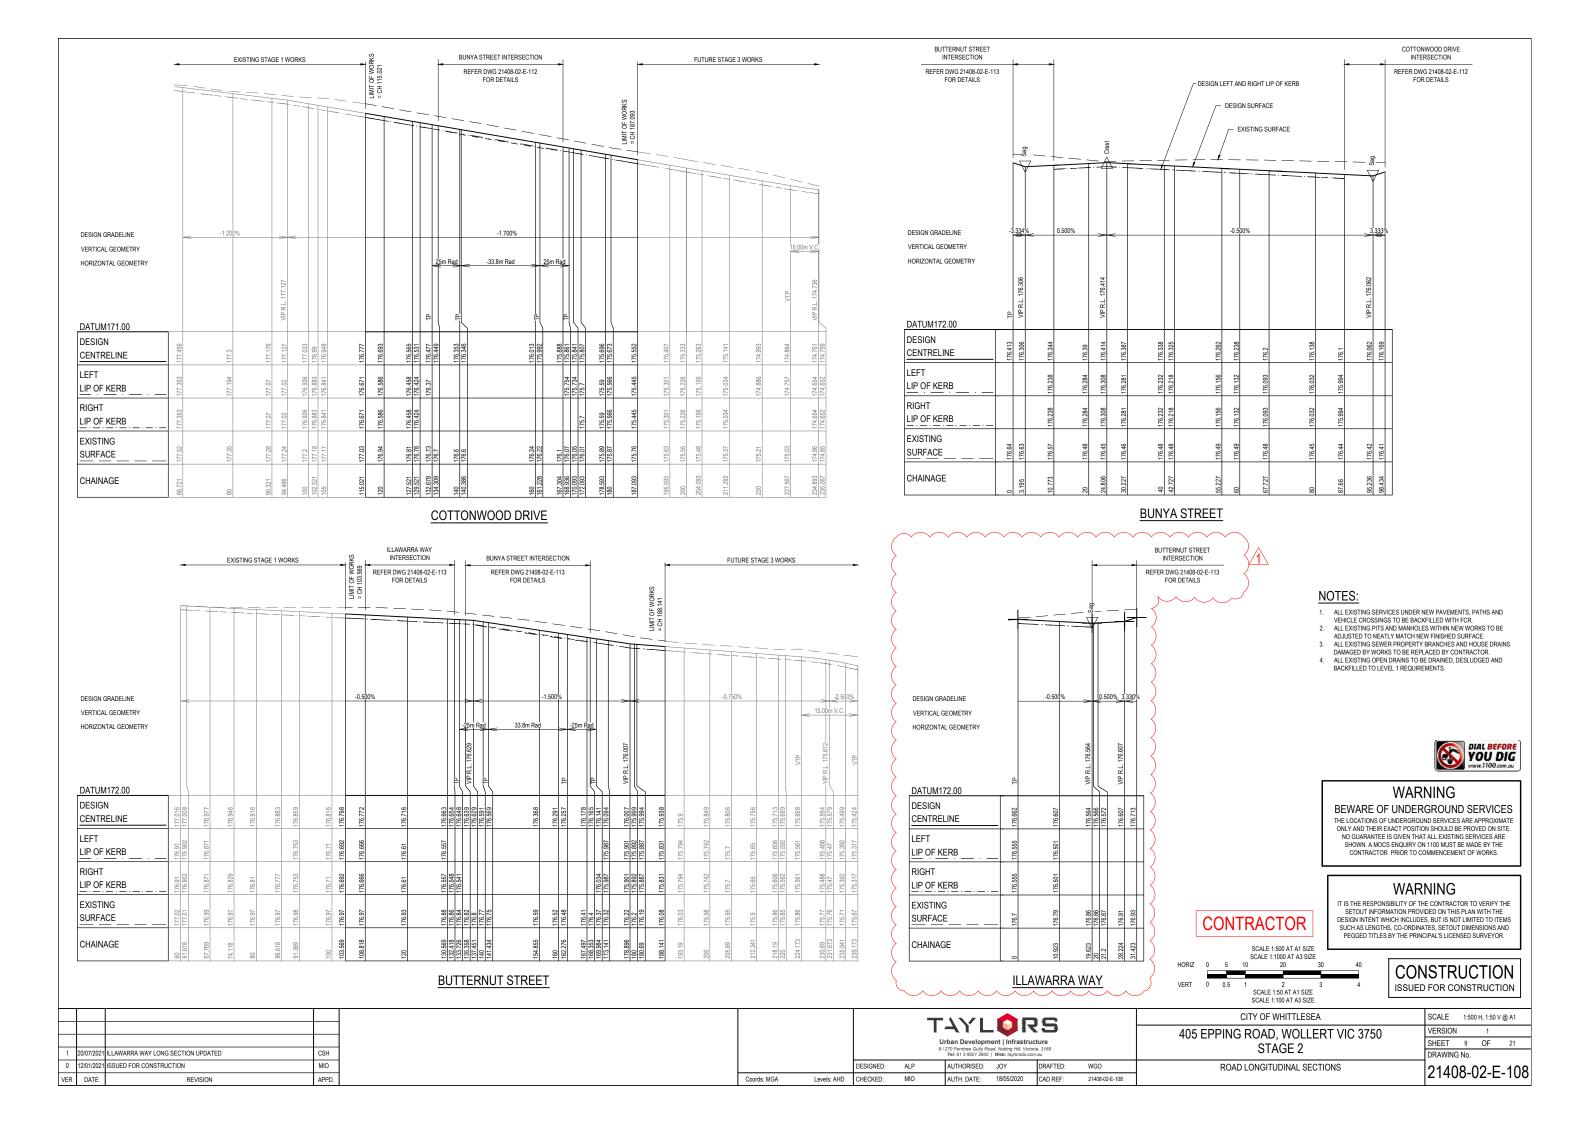


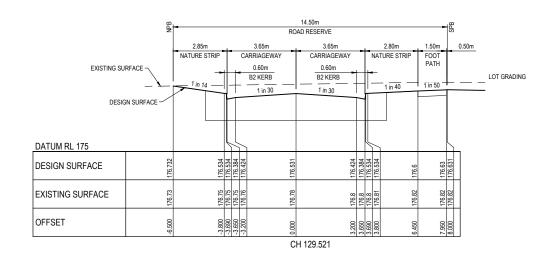

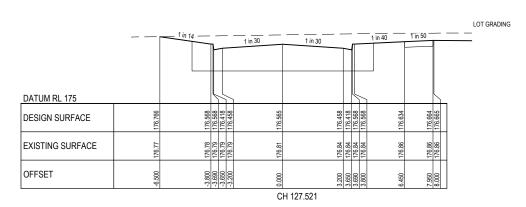

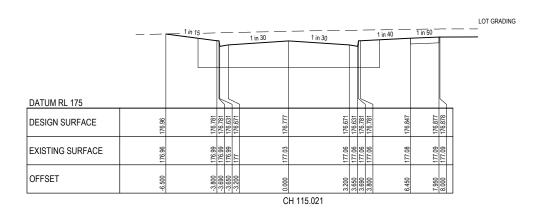

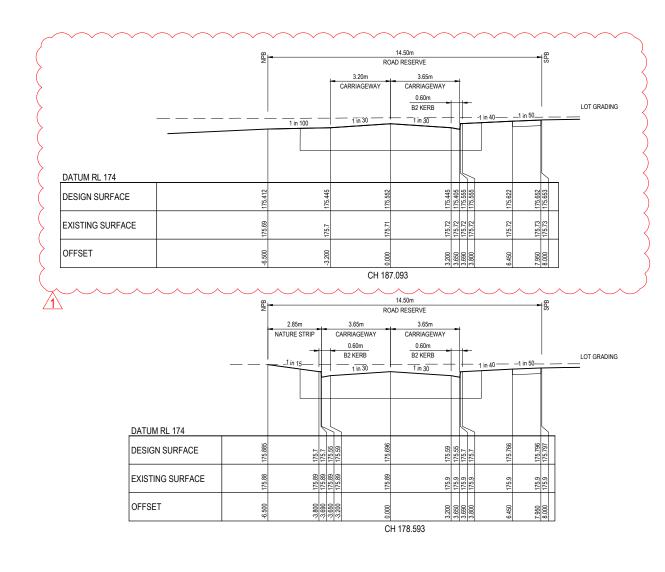

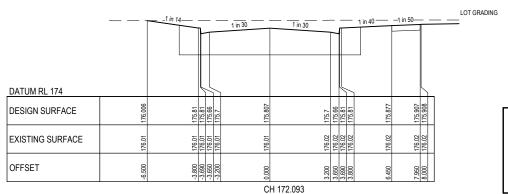




WARNING

BEWARE OF UNDERGROUND SERVICES

THE LOCATIONS OF UNDERGROUND SERVICES ARE APPROXIMATE ONLY AND THEIR EXACT POSITION SHOULD BE PROVED ON SITE. NO GUARANTEE IS GIVEN THAT ALL EXISTING SERVICES ARE SHOWN. A MOCS ENQUIRY ON 1100 MUST BE MADE BY THE CONTRACTOR PRIOR TO COMMENCEMENT OF WORKS.

WARNING

IT IS THE RESPONSIBILITY OF THE CONTRACTOR TO VERIFY THE SETOUT INFORMATION PROVIDED ON THIS PLAN WITH THE DESIGN INTENT WHICH INCLUDES, BUT IS NOT LIMITED TO ITEMS SUCH AS LENGTHS, CO-ORDINATES, SETOUT DIMENSIONS AND PEGGED TITLES BY THE PRINCIPAL'S LICENSED SURVEYOR.

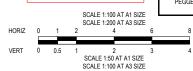



CONTRACTOR


CONSTRUCTION	
ISSUED FOR CONSTRUCTION	


												SCALE I: 100 AT A3 SIZE	
								17/1	ΔD	i C		CITY OF WHITTLESEA	SCALE 1:100 H, 1:50 V @ A1
			<u> </u>					→ 1 L	- 🕶 17	3		405 EPPING ROAD, WOLLERT VIC 3750	VERSION 1
L									ent Infrastruc			STAGE 2	SHEET 10 OF 21
	1/12/202	1 COTTONWOOD DRIVE CROSS SECTION UPDATED WJB					-		Web: taylorsds.com			OTAGE Z	DRAWING No.
	12/01/202	1 ISSUED FOR CONSTRUCTION MIO				DESIGNED:	ALP	AUTHORISED:	JOY	DRAFTED:	WGO	ROAD CROSS SECTIONS	21408-02-E-109
V	R DATE	REVISION APPE		Coords: MGA	Levels: AHD	CHECKED:	MIO	AUTH. DATE:	18/05/2020	CAD REF:	21408-02-E-109-111	SHEET 1 OF 3	2 1400-02-L-109


COTTONWOOD DRIVE

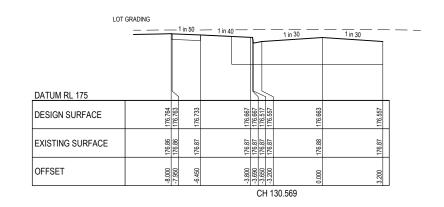


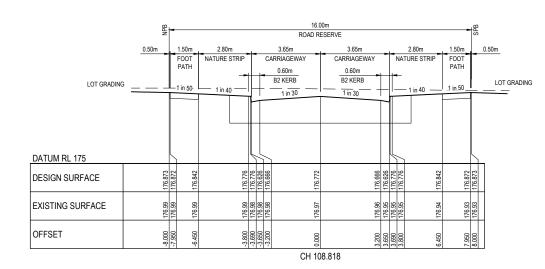

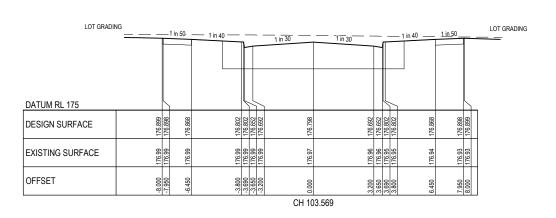

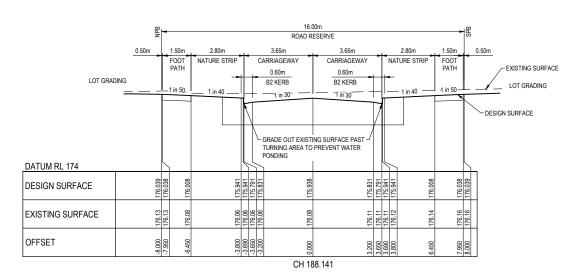

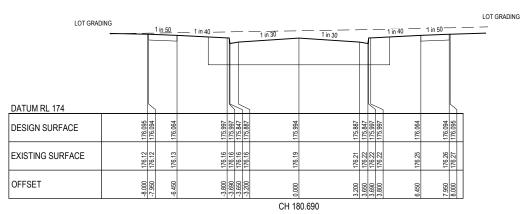

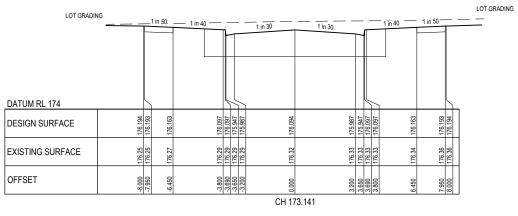




WARNING

BEWARE OF UNDERGROUND SERVICES

THE LOCATIONS OF UNDERGROUND SERVICES ARE APPROXIMATE ONLY AND THEIR EXACT POSITION SHOULD BE PROVED ON SITE. NO GUARANTEE IS GIVEN THALL EXISTING SERVICES ARE SHOWN. A MOCS ENQUIRY ON 1100 MUST BE MADE BY THE CONTRACTOR PRIOR TO COMMENCEMENT OF WORKS.

WARNING

IT IS THE RESPONSIBILITY OF THE CONTRACTOR TO VERIFY THE SETOUT INFORMATION PROVIDED ON THIS PLAN WITH THE DESIGN INTENT WHICH INCLUDES, BUT IS NOT LIMITED TO ITEMS SUCH AS LEAGTHS, CO-ORDINATES, SETOUT DIMENSIONS AND PEGGED TITLES BY THE PRINCIPAL'S LICENSED SURVEYOR.

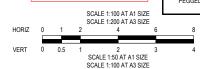



CONTRACTOR


CONSTRUCTION	
ISSUED FOR CONSTRUCTION	l

												SCALE 1:100 AT A3 SIZE	
							TIVI ABC					CITY OF WHITTLESEA	SCALE 1:100 H, 1:50 V @ A1
							141 - 143					405 EPPING ROAD, WOLLERT VIC 3750	VERSION 0
								Urban Developm 8 / 270 Ferntree Gully Ro				STAGE 2	SHEET 11 OF 21
								Tel: 61 3 9501 2800	Web: taylorsds.com	n.au		STAGE 2	DRAWING No.
0	12/01/202	21 ISSUED FOR CONSTRUCTION	MIO			DESIGNED:	ALP	AUTHORISED:	JOY	DRAFTED:	WGO	ROAD CROSS SECTIONS	21408-02-E-110
VER	DATE	REVISION	APPD.	Coords: MGA	Levels: AHD	CHECKED:	MIO	AUTH. DATE:	18/05/2020	CAD REF:	21408-02-E-109-111	SHEET 2 OF 3	Z 1400-02-L-110

BUTTERNUT STREET

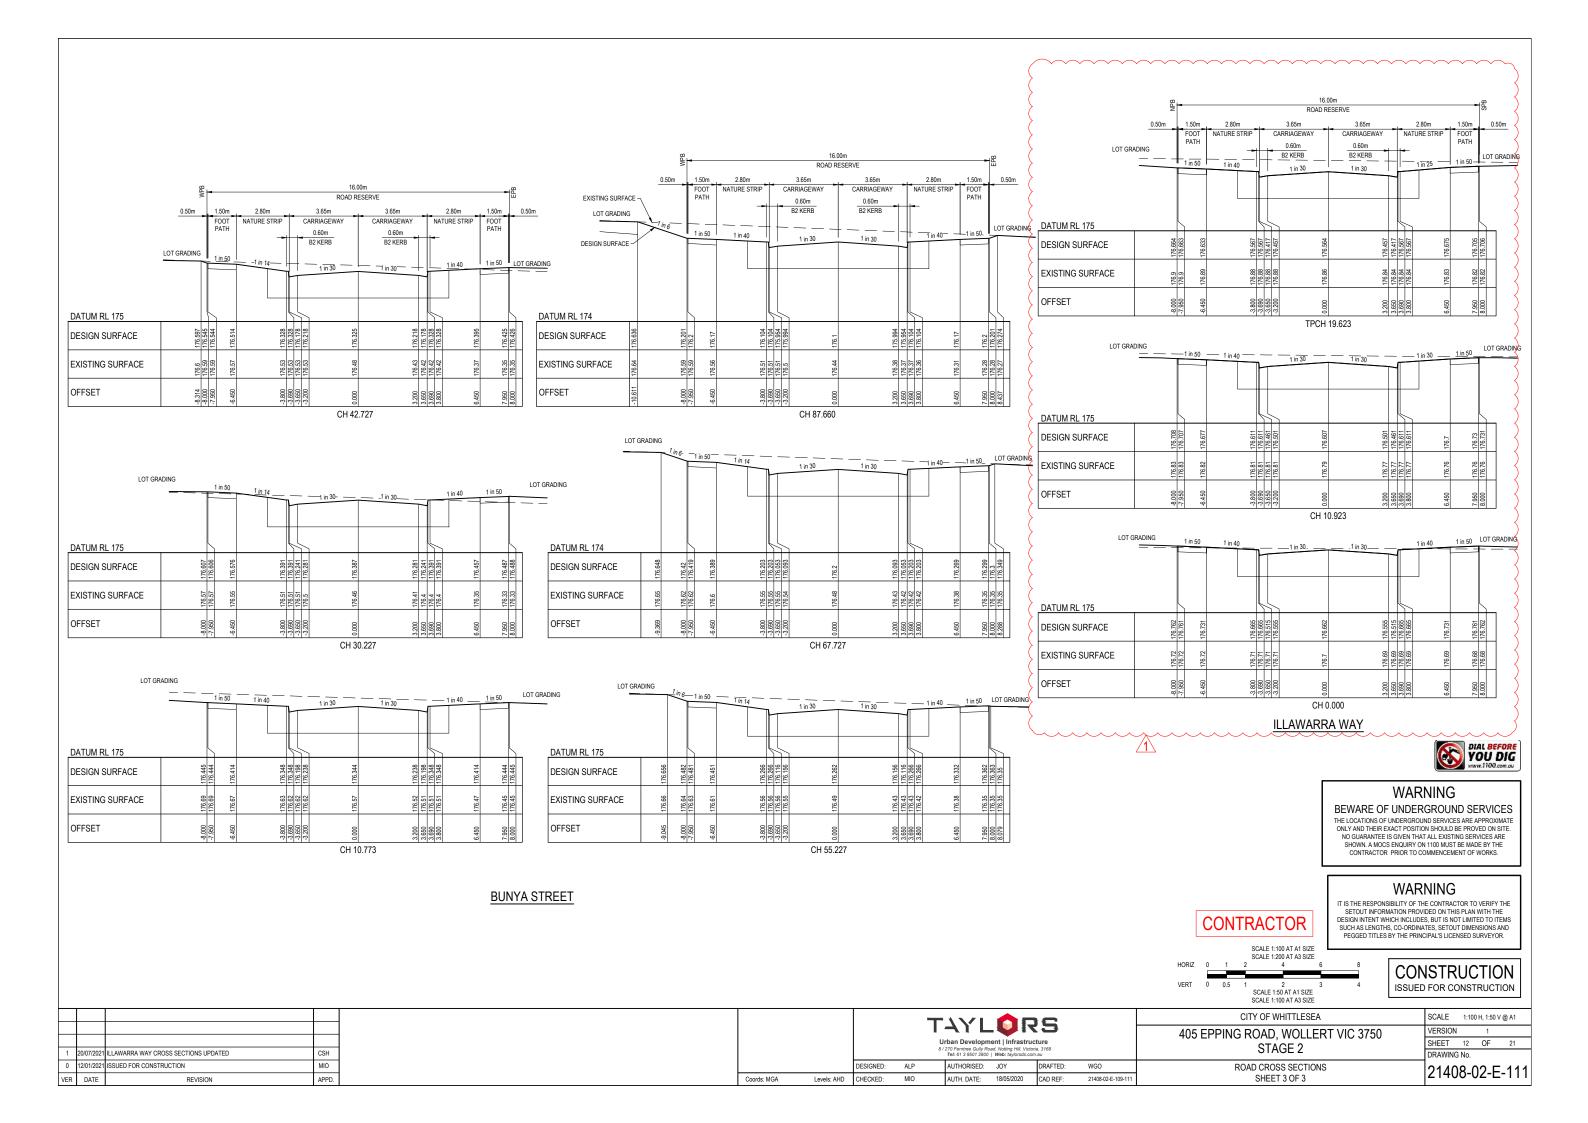

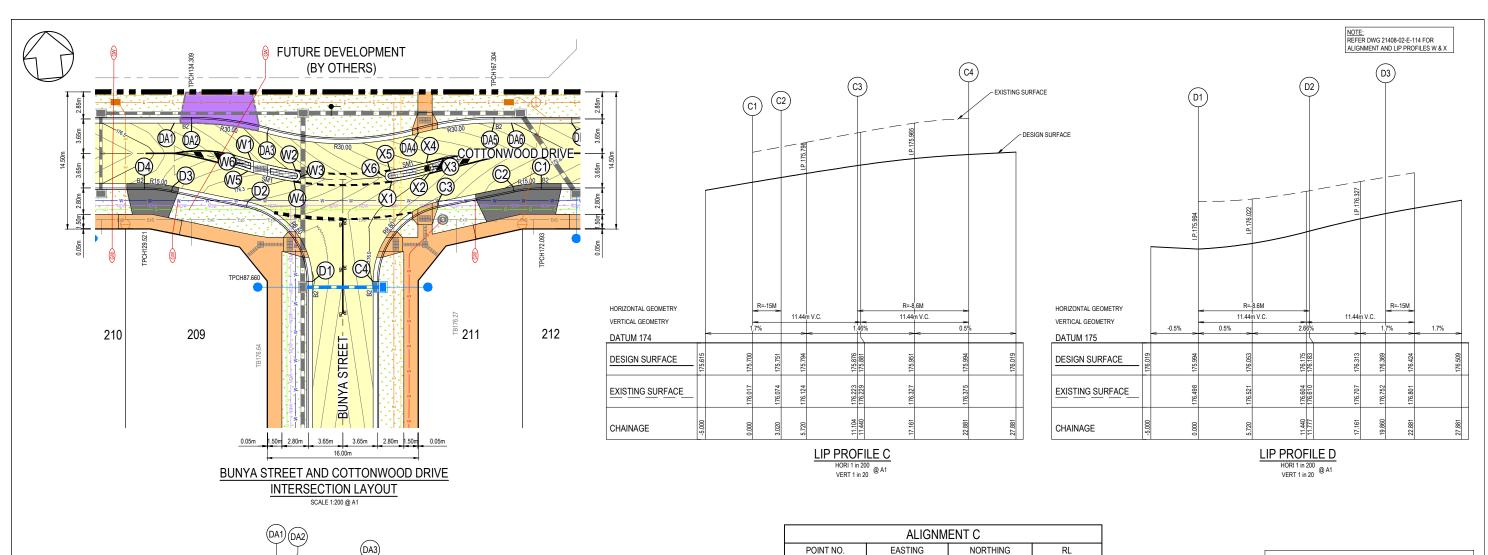

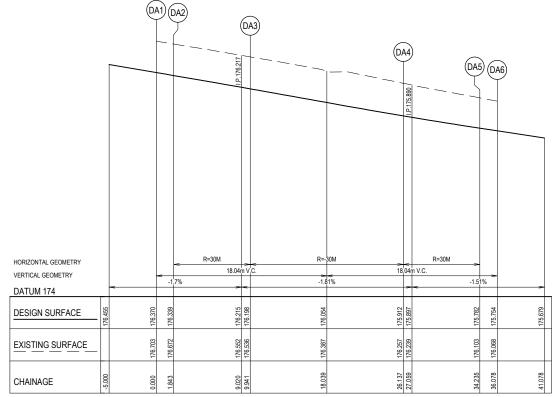

LIP PROFILE DA

HORI 1 in 200 VERT 1 in 20 @ A1

			ALI	GNM	IENT	С					
1 TAIO9	NO.	E.	ASTING			NORTH	IING		RL		
C1		3		5836605	.967		175.700				
C2		3:	26066.106			5836605	.976		175.751		
C3		3		5836605	.187		175.876				
C4		3:		5836597	.518		175.994				
CURVE NO.	ı	RADIUS	ARC	Α	В	Х	Υ	L	MID POINT RL		
C1 - C2	11.537	15	3.020	0.076	0.057	0.755	0.753	0.755	175.726		
C3 - C4	78.463	8.6	11.777	1.938	1.439	2.887	2.552	2.944	175.950		
			ALI	GNM	IENT	D					
POINT I	NO.	E	ASTING		NORTHING RL						
D1	3	26043.981			5836598	.180		175.994			
D2		3:	26038.010			5836607	.273		176.183		
D3		3:	26030.299			5836609	.700		176.369		
D4		3:	26027.347			5836610	.312		176.424		
CURVE NO.	I	RADIUS	ARC	Α	В	Х	Υ	L	MID POINT RL		
D1 - D2	78.463	8.6	11.777	1.938	1.439	2.887	2.552	2.944	176.056		
D3 - D4	11.537	15	3.020	0.076	0.057	0.755	0.753	0.755	176.397		
			ALIC	MM	ENT	DA					
POINT I	NO.	E	ASTING			NORTH	IING		RL		
DA1		3:	26031.149			5836616	3.351		176.370		
DA2		3:	26032.982			5836616	5.161		176.339		
DA3		3:	26040.827			5836614	.252		176.198		
DA4		3	26056.741			5836612	.597		175.912		
DA5		3:	26064.810			5836612	.850		175.782		
DA6		3:	26066.644			5836612	.659		175.754		
CURVE NO	I	RADIUS	ARC	Α	В	Χ	Υ	L	MID POINT RL		
DF1 - DF2	90.006	8.6	13.51	2.519	1.864	3.291	2.79	3.377	175.577		



NOTE

ALL RADII AND LEVELS ARE TO LIP OF KERB UNLESS OTHERWISE NOTED.
ALL LINEMARKING AND SIGNAGE ARE TO BE IN ACCORDANCE WITH
AS1742 - 1994. LINEMARKING STOUT SHALL BE INSPECTED AND
APPROVED BEFORE FINAL LINEMARKING IS CARRIED OUT.



WARNING


BEWARE OF UNDERGROUND SERVICES

THE LOCATIONS OF UNDERGROUND SERVICES ARE APPROXIMATE ONLY AND THEIR EXACT POSITION SHOULD BE PROVED ON SITE. NO GUARANTEE IS GIVEN THALL EXISTING SERVICES ARE SHOWN. A MOCS ENQUIRY ON 1100 MUST BE MADE BY THE CONTRACTOR PRIOR TO COMMENCEMENT OF WORKS.

WARNING


CONTRACTOR


IT IS THE RESPONSIBILITY OF THE CONTRACTOR TO VERIFY THE SETOUT INFORMATION PROVIDED ON THIS PLAN WITH THE DESIGN INTENT WHICH INCLUDES, BUT IS NOT LIMITED TO ITEMS SUCH AS LENGTHS, CO-ORDINATES, SETOUT DIMENSIONS AND PEGGED TITLES BY THE PRINCIPAL'S LICENSED SURVEYOR.

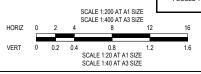


CONSTRUCTION ISSUED FOR CONSTRUCTION

			L'	PROPOSED NEW PAVEMENT	PROPUSED GAS MAIN	PROPOSED PROPERTY INLETS	1			_	- / / /	_	-		CITY OF WHITTLESEA	SCALE AS SHOWN @ A1
				PROPOSED CONCRETE PATH	PROPOSED NON-DRINKING WATER NDW	EXISTING DRAIN & PIT					711		<i>!</i>	-		
	1		<u> </u>	DDODOGED ODOGGOVED	PROPOSED WATER MAIN W	STREET NAME SIGN						- 🕶 :	-		405 EPPING ROAD, WOLLERT VIC 3750	VERSION 0
			Ľ	PROPOSED CROSSOVER	 PROPOSED ELECTRICITY CABLE & PIT - E -	P.S.M.					Urban Developm	nent Infrastru	cture			SHEET 13 OF 21
				PROPOSED LANDSCAPING	PROPOSED TELCO CABLE T T	PROPOSED GAS & WATER CONDUIT - GW	1				8 / 270 Ferntree Gully Ro				STAGE 2	
				PROPOSED PAVING	DDODOSED SEWED MAIN & M H		1				Tel: 61 3 9501 2800	Web: taylorsds.co	om.au			DRAWING No.
0	12/01/202	21 ISSUED FOR CONSTRUCTION MI	110	LITLINE ODGGGGGGGGGGGGGGGGGGGGGGGGGGGGGGGGGGGG	PROPOSED PRANTA DIT		1		DESIGNED:	ALP	AUTHORISED:	JOY	DRAFTED:	WGO	INTERSECTION DETAILS AND KERB LIP PROFILES	04400 00 E 440
	 			UTURE CROSSOVER (BT OTHERS)	PROPOSED DRAIN & PIT											21408-02-E-112
VER	DATE	REVISION AF	PPD.		LEGEND		Coords: MGA	Levels: AHD	CHECKED:	MIO	AUTH. DATE:	18/05/2020	CAD REF:	21408-02-E-112-115	SHEET 1 OF 4	
		<u> </u>														

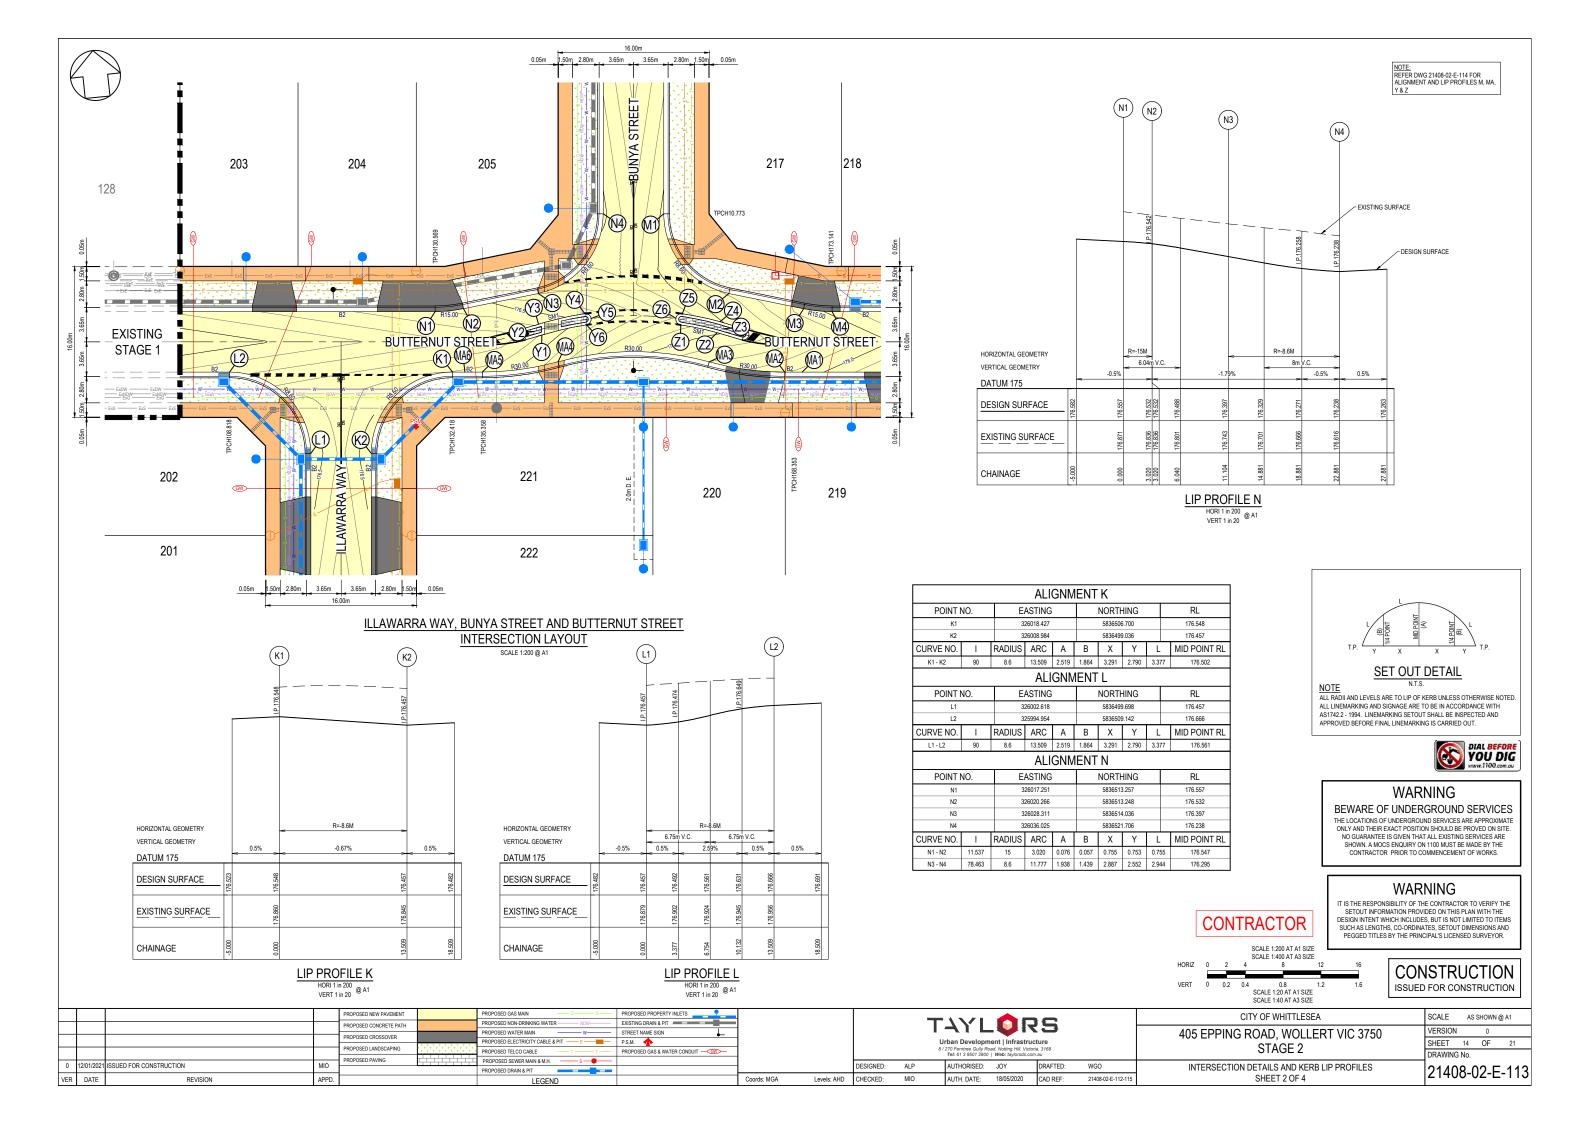

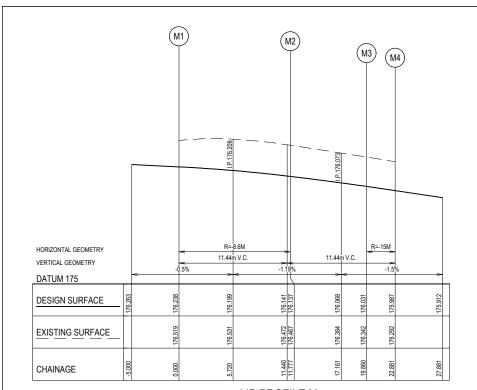

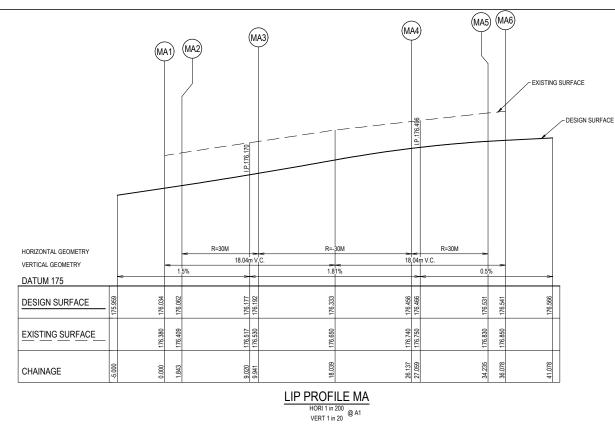

ALIGNMENT MA POINT NO. EASTING NORTHING RL MA1 326055.223 5836502.872 176.034 MA2 326053.390 5836503.063 176.062 MA3 326045.545 5836504.971 176.192 176.456 MA4 326029.631 5836506.627 MA5 326021.562 5836506.374 176.531 326019.728 5836506.565 176.541 RADIUS ARC A B X Y L MID POINT RL CURVE NO. MA2 - MA3 30 8.098 0.273 0.205 2.023 2.014 2.024 176.126 MA3 - MA4 30.932 30 16.196 1.086 0.814 4.037 3.96 4.049

30 8.098 0.273 0.205 2.023 2.014 2.024

MA4 - MA5 15.466

LIP PROFILE M

HORI 1 in 200
VERT 1 in 20 @ A1

ALIGNMENT M											
POINT	E	ASTING	i		NORTI	HING		RL			
M1		3	26042.391				176.238				
M2	3	26048.362			583651	1.951		176.137			
M3		3.	26056.073			583650	9.523		176.031		
M4		3.	26059.025			583650	8.911		175.987		
CURVE NO.	I	RADIUS	ARC	Α	В	Х	Υ	L	MID POINT RL		
M1 - M2	78.463	8.6	11.777	1.938	1.439	2.887	2.552	2.944	176.198		
M3 - M4	M3 - M4 11 537		3 020	0.076	0.057	0.755	0.753	0.755	176 009		

			ALI	GNIV	IENT	Χ						
POINT I	NO.	E/	ASTING			NORTH	IING		RL			
X1		3:	26053.396			5836607	'.821		176.06			
X2		3:	26057.455			5836608	.255			175.99		
X3		3:	26057.948		5836608.946					176		
X4		3:	26057.257		5836609.439					175.99		
X5		3:	26053.339			583660	9.02			176.06		
X6		3:	26052.768			5836608	.392		176.09			
CURVE NO.	- 1	RADIUS	ARC	Α	В	Χ	Υ	L		MID POINT RL		
X1 - X2	6.804	34.4	4.085	0.061	0.045	1.021	1.02	1.02	21	176.03		
X2 - X3	90	0.6	0.942	0.176	0.13	0.23	0.2	0.23	36	175.994		
X3 - X4 90		0.6	0.942	0.176	0.13	0.23	0.2	0.23	36	175.995		
X4 - X5	6.804	33.2	3.942	0.059	0.044	0.985	0.99	0.98	36	176.026		
X5 - X6	90	0.6	0.942	0.176	0.13	0.23	0.2	0.23	36	176.077		
X6 - X1	90	0.6	0.942	0.176	0.13	0.23	0.2	0.23	36	176.077		

			ALI	GNM	IENT	Υ			
POINT I	NO.	E,	ASTING		NORTHING RL				
Y1	3:	26028.234			176.54				
Y2		3	26027.53			5836510	.099		176.57
Y3		3:	26028.004			5836510	.803		176.54
Y4		3:	26032.976		5836511.402 176.47				
Y5		3:	26033.604			5836510).831		176.48
Y6		3:	26033.033			5836510	.204		176.47
CURVE NO.	- 1	RADIUS	ARC	Α	В	Χ	Υ	L	MID POINT RL
Y1 - Y2	90	0.6	0.942	0.176	0.13	0.23	0.2	0.23	6 176.558
Y2 - Y3	90	0.6	0.942	0.176	0.13	0.23	0.2	0.23	6 176.558
Y3 - Y4 8.349		34.4	5.013	0.091	0.068	1.253	1.25	1.25	3 176.507
Y4 - Y5	90	0.6	0.942	0.176	0.13	0.23	0.2	0.23	6 176.475
Y5 - Y6	90	0.6	0.942	0.176	0.13	0.23	0.2	0.23	6 176.474
Y6 - Y1	8.349	33.2	4.838	0.088	0.066	1.209	1.21	1.209	9 176.505

L
T.P. Y X X Y T.P.
SET OUT DETAIL
NOTE N.T.S.
ALL RADII AND LEVELS ARE TO LIP OF KERB UNLESS OTHERWISE NOTED. ALL LINEMARKING AND SIGNAGE ARE TO BE IN ACCORDANCE WITH AS1742. P1994. LINEMARKING STOUT SHALL BE INSPECTED AND APPROVED BEFORE FINAL LINEMARKING IS CARRIED OUT.

NOTE: REFER DWG 21408-02-E-113 FOR SETOUT M, MA, Y & X REFER DWG 21408-02-E-112 FOR SETOUT W & X

176.499



			ALIC	GNM	ENT	W				
POINT I	NO.	E,	ASTING		NORTHING RL					
W1		3:	26038.842			5836611	176.32			
W2		3:	26043.419			5836610	0.052		176.24	
W3		3:	26043.849		5836609.32 176.25					
W4		3:	26043.117			5836608	176.24			
W5		3:	26038.375			5836610).501		176.32	
W6		3:	26038.056		5836611.287					
CURVE NO.	I	RADIUS	ARC	Α	В	Χ	Υ	L	MID POINT RL	
W1 - W2	8.349	33.2	4.838	0.088	0.066	1.209	1.21	1.209	176.275	
W2 - W3	90	0.6	0.942	0.176	0.13	0.23	0.2	0.236	176.234	
W3 - W4	90	0.6	0.942	0.176	0.13	0.23	0.2	0.236	176.237	
W4 - W5	8.349	34.4	5.013	0.091	0.068	1.253	1.25	1.253	176.278	
W5 - W6	90	0.6	0.942	0.176	0.13	0.23	0.2	0.236	176.334	
W6 - W1	90	0.6	0.942	0.176	0.13	0.23	0.2	0.236	176.334	


ALIGNMENT Z											
POINT	NO.	E	ASTING	i		NORTH	RL				
Z1		3	326042.953				9.172		176.32		
Z2			326046.7				7.955		176.26		
Z3		3	26047.478			5836508	3.295		176.27		
Z4		3	26047.138			5836509	9.073		176.26		
Z5		3	26043.255			5836510	0.333		176.32		
Z6		3	26042.523			5836509	9.903		176.35		
CURVE NO.	I	RADIUS	ARC	Α	В	XY		L	MID POINT RL		
Z1 - Z2	6.804	33.2	3.942	0.059	0.044	0.985	0.99	0.986	176.285		
Z2 - Z3	90	0.6	0.942	0.176	0.13	0.23	0.2	0.236	176.261		
Z3 - Z4 90		0.6	0.942	0.176	0.13	0.23	0.2	0.236	176.262		
Z4 - Z5	6.804	34.4	4.085	0.061	0.045	1.021	1.02	1.021	176.288		
Z5 - Z6	90	0.6	0.942	0.176	0.13	0.23	0.2	0.236	176.33		
Z6 - Z1 90		0.6	0.942	0.176	0.13	0.23	0.2	0.236	176.331		



WARNING
IT IS THE RESPONSIBILITY OF THE CONTRACTOR TO VERIFY THE
SETOUT INFORMATION PROVIDED ON THIS PLAN WITH THE
DESIGN INTENT WHICH INCLUDES, BUT IS NOT LIMITED TO ITEMS
SUCH AS LENGTHS, CO-ORDINATES, SETOUT DIMENSIONS AND
PEGGED TITLES BY THE PRINCIPAL'S LICENSED SURVEYOR.

WARNING
BEWARE OF UNDERGROUND SERVICES

THE LOCATIONS OF UNDERGROUND SERVICES ARE APPROXIMATE ONLY AND THEIR EXACT POSITION SHOULD BE PROVED ON SITE. NO GUARANTEE IS GIVEN THAT ALL EXISTING SERVICES ARE SHOWN. A MOCS ENQUIRY ON 1100 MUST BE MADE BY THE CONTRACTOR PRIOR TO COMMENCEMENT OF WORKS.

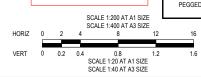

CONSTRUCTION
ISSUED FOR CONSTRUCTION

				1
				1
				1
0	12/01/2021	ISSUED FOR CONSTRUCTION	MIO	1
VER	DATE	REVISION	APPD.	L

				T	4YL	. OF	?S	
					rban Developm 270 Ferntree Gully Ro Tel: 61 3 9501 2800	ad, Notting Hill, Victo	oria, 3168	
		DESIGNED:	ALP		AUTHORISED:	JOY	DRAFTED:	WGO
Coords: MGA	Levels: AHD	CHECKED:	MIO		AUTH. DATE:	18/05/2020	CAD REF:	21408-02-E-112-115

CITY OF WHITTLESEA


405 EPPING ROAD, WOLLERT VIC 3750
STAGE 2

INTERSECTION DETAILS AND KERB LIP PROFILES SHEET 3 OF 4


SCALE	AS	SHOWN (@ A1
VERSION		0	
SHEET	15	OF	21
DRAWING	No.		

ILS AND KERB LIP PROFILES 21408-02-E-114



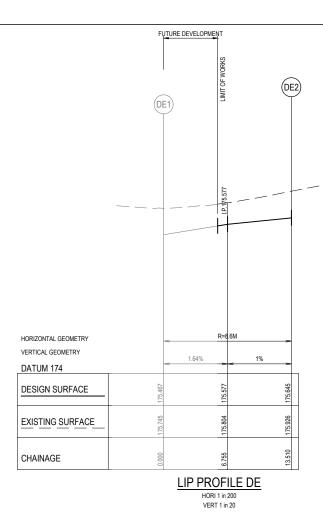

ALIGNMENT DE												
POINT I	Е		NORTH	IING		RL						
DE1		32	326082.443				9.662		175.467			
DE2	32	326072.999				1.997		175.645				
CURVE NO	ı	RADIUS	ARC	Α	В	Х	Υ	L	MID POINT RL			
DE1 - DE2 90.006		8.6 13.51 2.519		1.864 3.291		2.79	3.377	7 175.577				

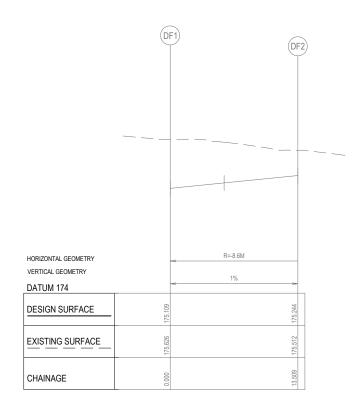

213

COTTONWOOD DRIVE

INTERSECTION LAYOUT

212

			ALI	GNMEN	NT DF					
POINT	NO	E	ASTING		N	ORTHI		RL		
DF	1	32	6088.809		58	36618.9		175.109		
DF:	2	32	6096.473		5	836609.5		175.244		
CURVE NO	Ī	RADIUS	ARC	Α	В	Х	Υ	L	MID POINT RL	
DF1 - DF2	89.999	8.6	13.509	2.519	1.864	3.291	2.79	3.377	175.177	

LIP PROFILE DF VERT 1 in 20

ROPOSED ELECTRICITY CABLE & PIT -P.S.M. 1 PROPOSED SEWER MAIN & M.H. 0 2/12/2021 ISSUED FOR CONSTRUCTION PROPOSED DRAIN & PIT VER DATE APPD. REVISION LEGEND

FUTURE DEVELOPMENT (BY OTHERS)

-COTTÔNWOOD DĂIVE

T4YLORS DESIGNED: ALP AUTHORISED: JOY DRAFTED:

AUTH. DATE: 18/05/2020 CAD REF:

Levels: AHD CHECKED:

STAGE 2

CONTRACTOR

INTERSECTION DETAILS AND KERB LIP PROFILES SHEET 4 OF 4

SET OUT DETAIL

N.T.S.

ALL RADII AND LEVELS ARE TO LIP OF KERB UNLESS OTHERWISE NOTED.
ALL LINEMARKING AND SIGNAGE ARE TO BE IN ACCORDANCE WITH
AS1742.2 - 1994. LINEMARKING SETOUT SHALL BE INSPECTED AND
APPROVED BEFORE FINAL LINEMARKING IS CARRIED OUT.

WARNING BEWARE OF UNDERGROUND SERVICES

THE LOCATIONS OF UNDERGROUND SERVICES ARE APPROXIMATE ONLY AND THEIR EXACT POSITION SHOULD BE PROVED ON SITE. NO GUARANTEE IS GIVEN THAT ALL EXISTING SERVICES ARE SHOWN. A MOCS ENQUIRY ON 1100 MUST BE MADE BY THE CONTRACTOR PRIOR TO COMMENCEMENT OF WORKS.

WARNING

IT IS THE RESPONSIBILITY OF THE CONTRACTOR TO VERIFY THE SETOUT INFORMATION PROVIDED ON THIS PLAN WITH THE DESIGN INTENT WHICH INCLUDES, BUT IS NOT LIMITED TO ITEMS SUCH AS LENGTHS, CO-ORDINATES, SETOUT DIMENSIONS AND PEGGED TITLES BY THE PRINCIPAL'S LICENSED SURVEYOR.

CITY OF WHITTLESEA
405 EPPING ROAD, WOLLERT VIC 3750
074.05.0

SCALE 1:200 AT A1 SIZE SCALE 1:400 AT A3 SIZE


4 0.8 SCALE 1:20 AT A1 SIZE SCALE 1:40 AT A3 SIZE


VERSION 0 SHEET 16 OF DRAWING No.

SCALE AS SHOWN @ A1

21408-02-E-115

DIAL BEFORE
YOU DIG

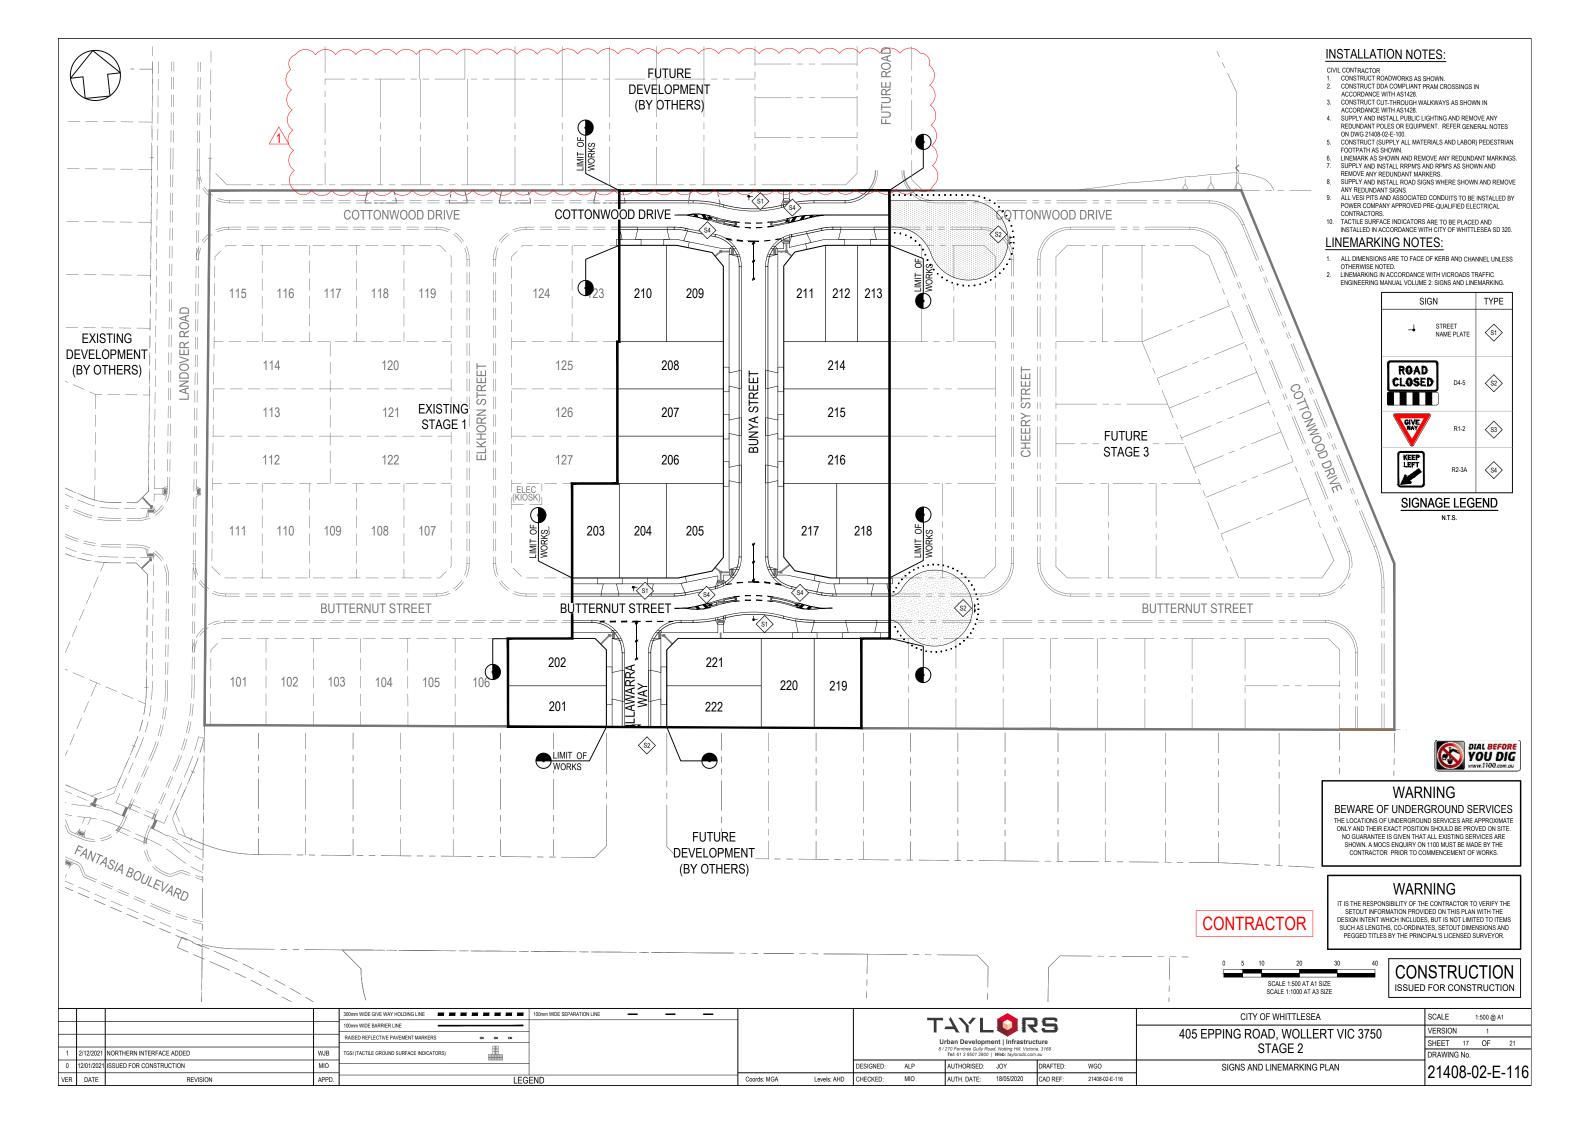


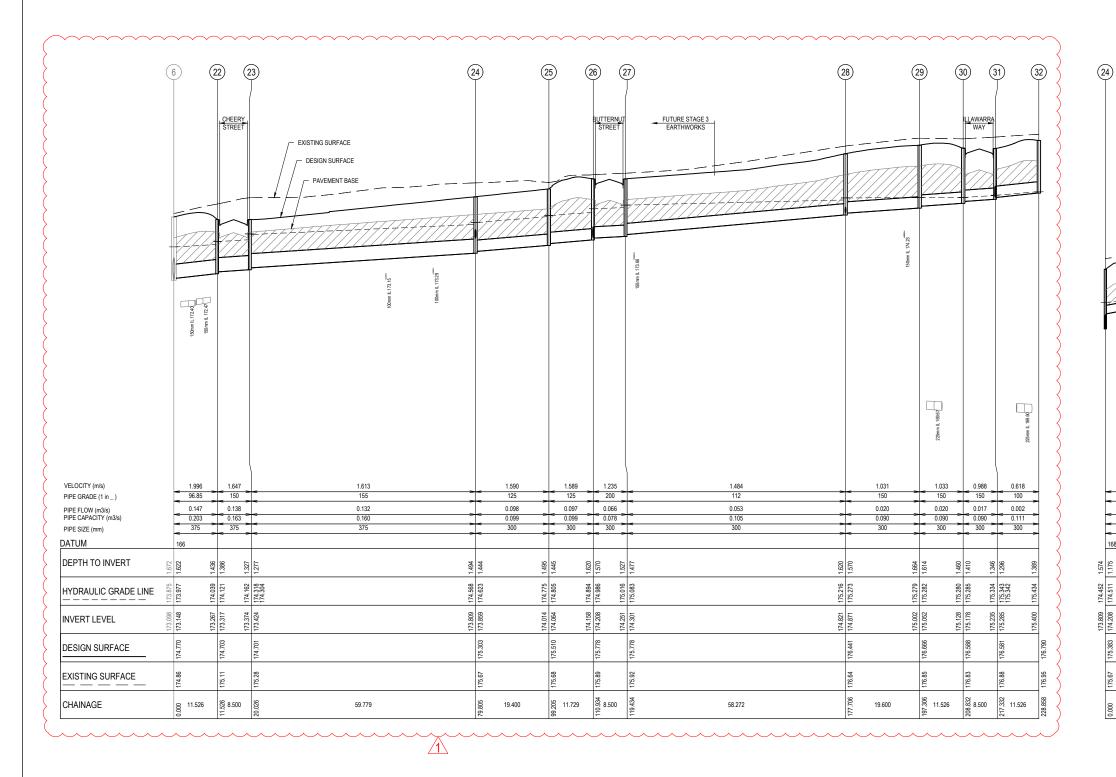

NOTES

- PIPE ARE TO BE CLASS 2 AND RRJ UNLESS
 NOTEO OTHERWISE.

 STRUCTURAL FILL USED ONLY WHEN EXISTING SURFACE IS BELOW FOOTPATH.

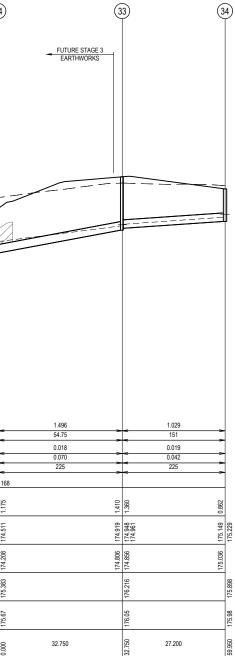



WARNING


BEWARE OF UNDERGROUND SERVICES

THE LOCATIONS OF UNDERGROUND SERVICES ARE APPROXIMATE ONLY AND THEIR EXACT POSITION SHOULD BE PROVED ON SITE. NO GUARANTEE IS GIVEN THALL EXISTING SERVICES ARE SHOWN. A MOCS ENQUIRY ON 1100 MUST BE MADE BY THE CONTRACTOR PRIOR TO COMMENCEMENT OF WORKS.

WARNING

CONTRACTOR

IT IS THE RESPONSIBILITY OF THE CONTRACTOR TO VERIFY THE SETOUT INFORMATION PROVIDED ON THIS PLAN WITH THE DESIGN INTENT WHICH INCLUDES, BUT IS NOT LIMITED TO ITEMS SUCH AS LENGTHS, CO-ORDINATES, SETOUT DIMENSIONS AND PEGGED TITLES BY THE PRINCIPAL'S LICENSED SURVEYOR.

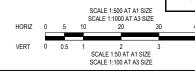


CONSTRUCTION ISSUED FOR CONSTRUCTION

												SCALE 1:100 AT A3 SIZE	_
			LEGEND					- / //	♠ E	16		CITY OF WHITTLESEA	SCALE 1:500 H, 1:50 V @ A1
						I A I L VIKS				(3		405 EPPING ROAD, WOLLERT VIC 3750	VERSION 1
	DENOTES 20mm CLASS 2 FCR BACKFILL						Urban Development Infrastructure 8/270 Ferntree Gully Road, Notting Hill, Victoria, 3168					STAGE 2	SHEET 18 OF 21
1 20/07/202	21 LONGITUDINAL SECTION UPDATED	CSH							Web: taylorsds.com			STAGE 2	DRAWING No.
0 12/01/202	21 ISSUED FOR CONSTRUCTION	MIO				DESIGNED:	ALP	AUTHORISED:	JOY	DRAFTED:	WGO	DRAINAGE LONGITUDINAL SECTIONS	21408-02-E-117
VER DATE	REVISION	APPD		Coords: MGA	Levels: AHD	CHECKED:	MIO	AUTH, DATE:	18/05/2020	CAD REF:	21408-02-E-117-118	SHEET 1 OF 2	21400-02-L-111

NOTES

- PIPE ARE TO BE CLASS 2 AND RRJ UNLESS
 NOTEO OTHERWISE.

 STRUCTURAL FILL USED ONLY WHEN EXISTING SURFACE IS BELOW FOOTPATH.

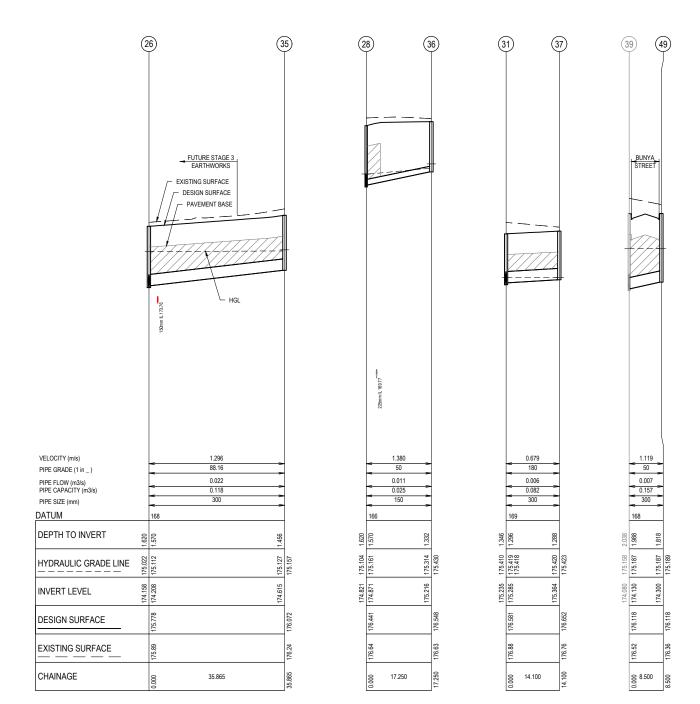



WARNING


BEWARE OF UNDERGROUND SERVICES

THE LOCATIONS OF UNDERGROUND SERVICES ARE APPROXIMATE ONLY AND THEIR EXACT POSITION SHOULD BE PROVED ON SITE. NO GUARANTEE IS GIVEN THAT ALL EXISTING SERVICES ARE SHOWN. A MOCS ENQUIRY ON 1100 MUST BE MADE BY THE CONTRACTOR PRIOR TO COMMENCEMENT OF WORKS.

WARNING

CONTRACTOR

IT IS THE RESPONSIBILITY OF THE CONTRACTOR TO VERIFY THE SETOUT INFORMATION PROVIDED ON THIS PLAN WITH THE DESIGN INTENT WHICH INCLUDES, BUT IS NOT LIMITED TO ITEMS SUCH AS LENGTHS, CO-ORDINATES, SETOUT DIMENSIONS AND PEGGED TITLES BY THE PRINCIPAL'S LICENSED SURVEYOR.

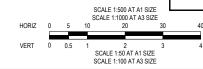

CONSTRUCTION ISSUED FOR CONSTRUCTION
ISSUED FOR CONSTRUCTION

			LEGEND DENOTES 20mm CLASS 2 FCR BACKFILL				T\VI ABS					CITY OF WHITTLESEA	SCALE 1:500 H, 1:50 V @ A1
						Urban Development Infrastructure						403 EFFING ROAD, WOLLLIN VIC 3730	VERSION 0 SHEET 19 OF 21
			DENOTES ZUMM CLASS Z FOR BACAFILL					8 / 270 Ferntree Gully R		toria, 3168		STAGE 2	DRAWING No.
0	2/01/2021	ISSUED FOR CONSTRUCTION MIC				DESIGNED:	ALP	AUTHORISED:	JOY	DRAFTED:	WGO	DRAINAGE LONGITUDINAL SECTIONS	21408-02-E-118
VER	DATE	REVISION APP).	Coords: MGA	Levels: AHD	CHECKED:	MIO	AUTH. DATE:	18/05/2020	CAD REF:	21408-02-E-117-118	SHEET 2 OF 2	21400-02-L-110

								PIT	SCHEE	ULE		
	Р	IT		INTE	RNAL	ı	INLET		UTLET	PIT		REMARKS
NAME	TYPE	EASTING	NORTHING	WD	LEN	DIA	INV LEV	DIA	INV LEV	SETOUT RL	DEPTH	NEWANNO
6 (EXISTING)	JP	326132.072	5836598.362	0.900	0.900	375	173.166			174.770	1.654	CONNECT INTO EXISTING PIT
11 (EXISTING)	JP(FUT.GSEP)	326023.542	5836618.198	0.600	0.900	300	174.693	300	174.643	176.645	2.002	PIT TO BE MODIFIED INTO GSEP AND MATCH FS
12 (EXISTING)	JP(FUT.GSEP)	326022.663	5836609.744	0.600	0.900	300	174.955	300	174.905	176.624	1.718	PIT TO BE MODIFIED INTO GSEP AND MATCH FS
~~~	~~~	~~	~~~	<u></u>	$\sim$	<u></u>	$\sim$	<u></u>	<b>~~</b>	~~~	<b>~</b>	
22	JP(FUT.GSEP)	326123.123	5836591.099	0.900	0.600	375	173.317	375	173.267	174.703	1.436	CONSTRUCT AS PER EDCM 605. PIT TO BE MODIFIED INTO GSEP IN STAGE 3.
23	JP(FUT.GSEP)	326114.669	5836591.979	0.600	0.900	375	173.424	375	173.374	174.701	1.327	CONSTRUCT AS PER EDCM 605. PIT TO BE MODIFIED INTO GSEP IN STAGE 3.
24	JP	326108.483	5836532.521	0.600	0.900	300	173.859	375	173.809	175.303	1.494	CONSTRUCT AS PER EDCM 605
						225	174.208					
25	JP(FUT.GSEP)	326106.476	5836513.225	0.600	0.900	300	174.064	300	174.014	175.510	1.495	CONSTRUCT AS PER EDCM 605. PIT TO BE MODIFIED INTO GSEP IN STAGE 3.
26	JP(FUT.GSEP)	326097.243	5836505.991	0.900	0.600	300	174.208	300	174.158	175.778	1.620	CONSTRUCT AS PER EDCM 605. PIT TO BE MODIFIED INTO GSEP IN STAGE 3.
						300	174.208					
27	JP(FUT.GSEP)	326096.369	5836497.536	0.600	0.900	300	174.301	300	174.251	175.778	1.527	CONSTRUCT AS PER EDCM 605. PIT TO BE MODIFIED INTO GSEP IN STAGE 3.
28	JP	326038.410	5836503.566	0.600	0.900	300	174.871	300	174.821	176.441	1.620	CONSTRUCT AS PER EDCM 605
						150	174.871					
29	JP	326018.915	5836505.594	0.600	0.900	300	175.052	300	175.002	176.666	1.664	CONSTRUCT AS PER EDCM 605
30	DGSEP	326009.966	5836498.331	0.600	0.900	300	175.178	300	175.128	176.588	1.460	CONSTRUCT AS PER EDCM 602
31	DGSEP	326001.511	5836499.210	0.900	0.600	300	175.285	300	175.235	176.581	1.346	CONSTRUCT AS PER EDCM 602
						300	175.285					
32	GSEP	325994.248	5836508.160	0.600	0.900			300	175.400	176.790	1.389	CONSTRUCT AS PER EDCM 601
33	JP	326075.909	5836535.909	0.900	0.600	225	174.856	225	174.806	176.216	1.410	CONSTRUCT AS PER EDCM 605
34	JP	326078.723	5836562.963	0.600	0.900			225	175.036	175.980	0.944	CONSTRUCT AS PER EDCM 605
35	GSEP	326061.571	5836509.702	0.600	0.900			300	174.615	176.072	1.456	CONSTRUCT AS PER EDCM 601
36	JP	326036.625	5836486.408	0.600	0.900			150	175.216	176.548	1.332	CONSTRUCT AS PER EDCM 605
37	JP	326000.053	5836485.186	0.600	0.900			300	175.364	176.652	1.288	CONSTRUCT AS PER EDCM 605
39 (EXISTING)	JP(FUT.GSEP)	326042.874	5836597.692	0.600	0.900	300	174.130			176.118	2.038	CONNECT INTO EXISTING PIT. PIT TO BE MODIFIED INTO GSEP AND MATCH FS
40 (EXISTING)	JP	326040.977	5836579.457	0.600	0.900	375	174.281	375	174.231	176.227	1.996	PIT TO MATCH FS LEVEL
						225	174.932					
41 (EXISTING)	JP(FUT.GSEP)	326035.043	5836522.411	0.600	0.900	375	174.618	375	174.568	176.366	1.797	PIT TO BE MODIFIED INTO GSEP AND MATCH FS
42 (EXISTING)	JP	326031.581	5836516.674	0.600	0.900	375	174.837	375	174.787	176.449	1.662	PIT TO MATCH FS LEVEL
43 (EXISTING)	JP(FUT.GSEP)	326009.701	5836515.098	0.600	0.900	375	175.022	375	174.947	176.717	1.770	PIT TO BE MODIFIED INTO GSEP AND MATCH FS
49	GSEP	326051.329	5836596.813	0.600	0.900			300	174.300	176.118	1.818	CONSTRUCT AS PER EDCM 601
									NOTE:			
1 XY SETOUT	TO PIT CENTRE											


2. SETOUT LEVEL TO PIT COVER LEVEL

3. SOME SETOUT XY OR Z LEVELS HAVE SPECIAL SETOUT DATA. SEE INDIVIDUAL MANHOLE REMARKS

5. FILL IS TO BE PROVIDED AROUND THE PITS WHERE TOP OF PITS ARE ABOVE ES LEVELS

6. NO PONDING IS TO OCCUR WHERE PITS ARE BELOW ES LEVEL

4. ALL PITS LOCATED IN FUTURE STAGES ARE TO BE CONSTRUCTED AS A JP (EDCM 605) AND TO FINISHED SURFACE LEVELS

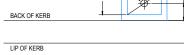

# PIT SETOUT POINT

LEGEND:
JP JUNCTION PIT
GSEP GRATED SIDE ENTRY PIT
DGSEP DOUBLE GRATE SIDE ENTRY PIT

REFERENCE POINT (CENTRE OF LID) -



# WARNING

### BEWARE OF UNDERGROUND SERVICES

THE LOCATIONS OF UNDERGROUND SERVICES ARE APPROXIMATE ONLY AND THEIR EXACT POSITION SHOULD BE PROVED ON SITE. NO GUARANTEE IS GIVEN THAT ALL EXISTING SERVICES ARE SHOWN. A MOCS ENQUIRY ON 1100 MUST BE MADE BY THE CONTRACTOR PRIOR TO COMMENCEMENT OF WORKS.

# WARNING

CONTRACTOR

IT IS THE RESPONSIBILITY OF THE CONTRACTOR TO VERIFY THE SETOUT INFORMATION PROVIDED ON THIS PLAN WITH THE DESIGN INTENT WHICH INCLUDES, BUT IS NOT LIMITED TO ITEMS SUCH AS LENGTHS, CO-ORDINATES, SETOUT DIMENSIONS AND PEGGED TITLES BY THE PRINCIPAL'S LICENSED SURVEYOR.



CONSTRUCTION ISSUED FOR CONSTRUCTION

				Γ
				1
1	20/07/2021	PIT SCHEDULE UPDATED	CSH	1
0	12/01/2021	ISSUED FOR CONSTRUCTION	MIO	1
VER	DATE	REVISION	APPD.	1

		TAYLORS  Urban Development   Infrastructure  8/270 Fernine Gully Road, Notting Hill, Victoria, 3168 Tel-6/13 35072 2001   Wei Silyrodras com au						
		DESIGNED:	ALP		AUTHORISED:	JOY	DRAFTED:	WGO
orde: MGA	Lovole: AHD	CHECKED:	MIO		ALITH DATE:	18/05/2020	CAD DEE:	21/INR_02_E_11

CITY OF WHITTLESEA 405 EPPING ROAD, WOLLERT VIC 3750 STAGE 2

SCALE 1:50 @ A1 VERSION SHEET 20 OF 21 DRAWING No.

21408-02-E-119

DRAINAGE PIT SCHEDULE

